90684

T.14S., R.9&10W., W.M.

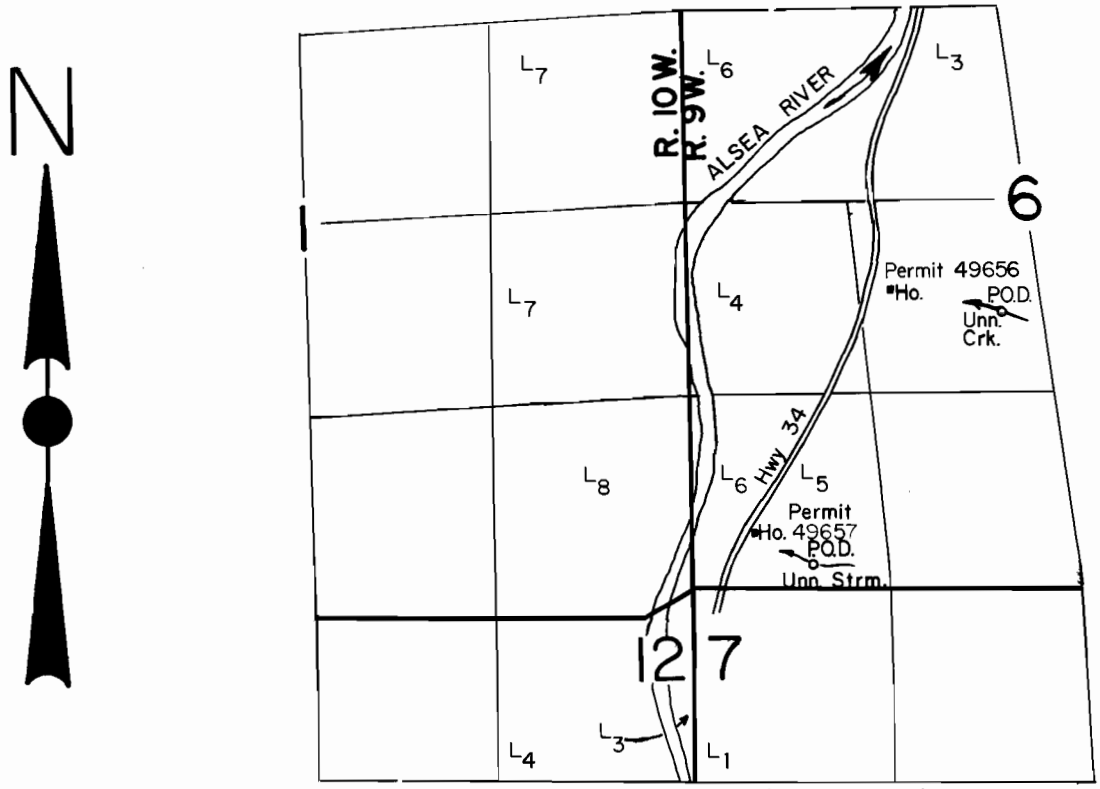

Permit 49656 ; P.O.D. Loc. : 1890' N. & 2160' E.
Permit 49657 ; P.O.D. Loc. : 160' N. & 820' E., both from SW Cor. Sec. 6.

Scale : 1" = 1320'

FINAL PROOF SURVEY
UNDER

68662 49656
Application No. 68663 Permit No. 49657
IN NAME OF

KENNETH & LOIS THISSELL

Surveyed Sept 20 1989, by R. KLASSEN

41041-272-143
41041-272-145
4/2/90 TMW