


T.14 S., R. 9 & 10 W., W.M.

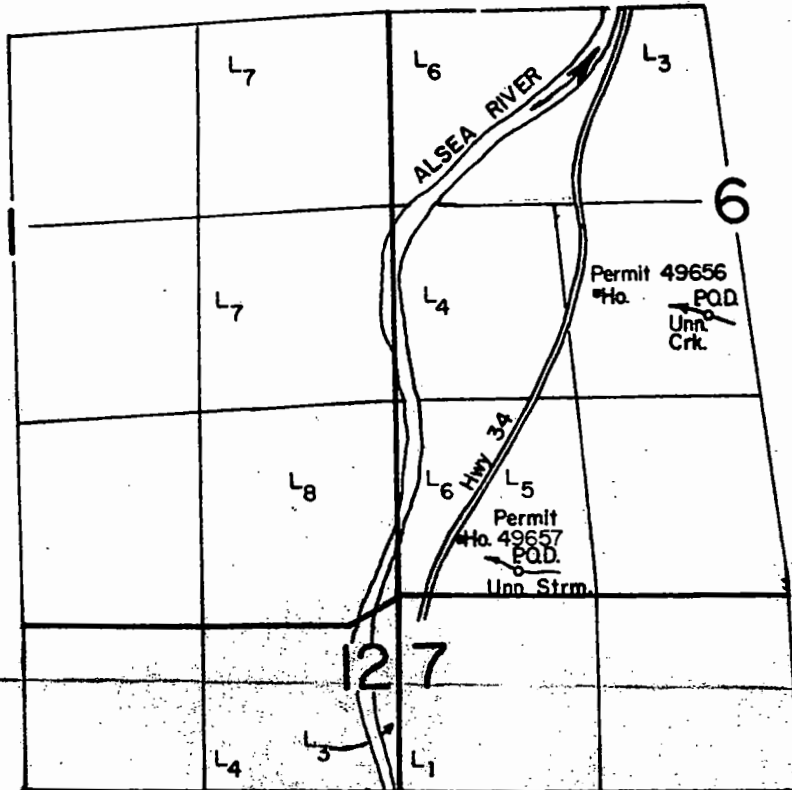

Permit 49656 ; P.O.D. Loc. : 1890' N. & 2160' E.  
Permit 49657 ; P.O.D. Loc. : 160' N. & 820' E., both from SW Cor. Sec. 6.

Scale: 1" = 1320'

**FINAL PROOF SURVEY**  
UNDER

Application No. 68662 Permit No. 49656  
Application No. 68663 Permit No. 49657

IN NAME OF

**KENNETH & LOIS THISSELL**

Surveyed Sept. 20, 1989, by R. KLASSEN.....

41041-272-143  
41041-272-145  
4/2/90 T.M.W.