

SURVEY FOR
LUKE BIRKY


LINCOLN COUNTY, OREGON
SCALE 1" = 100' DECEMBER 21, 1986

LEGEND

- Found 1/2" iron rods - C.S. 5966
- () Bearings and distances of record
- Proposed route of water line
- ~o~o~o Spring

RECEIVED

FEB 5 1987
WATER RESOURCES DEPT
SALEM OREGON

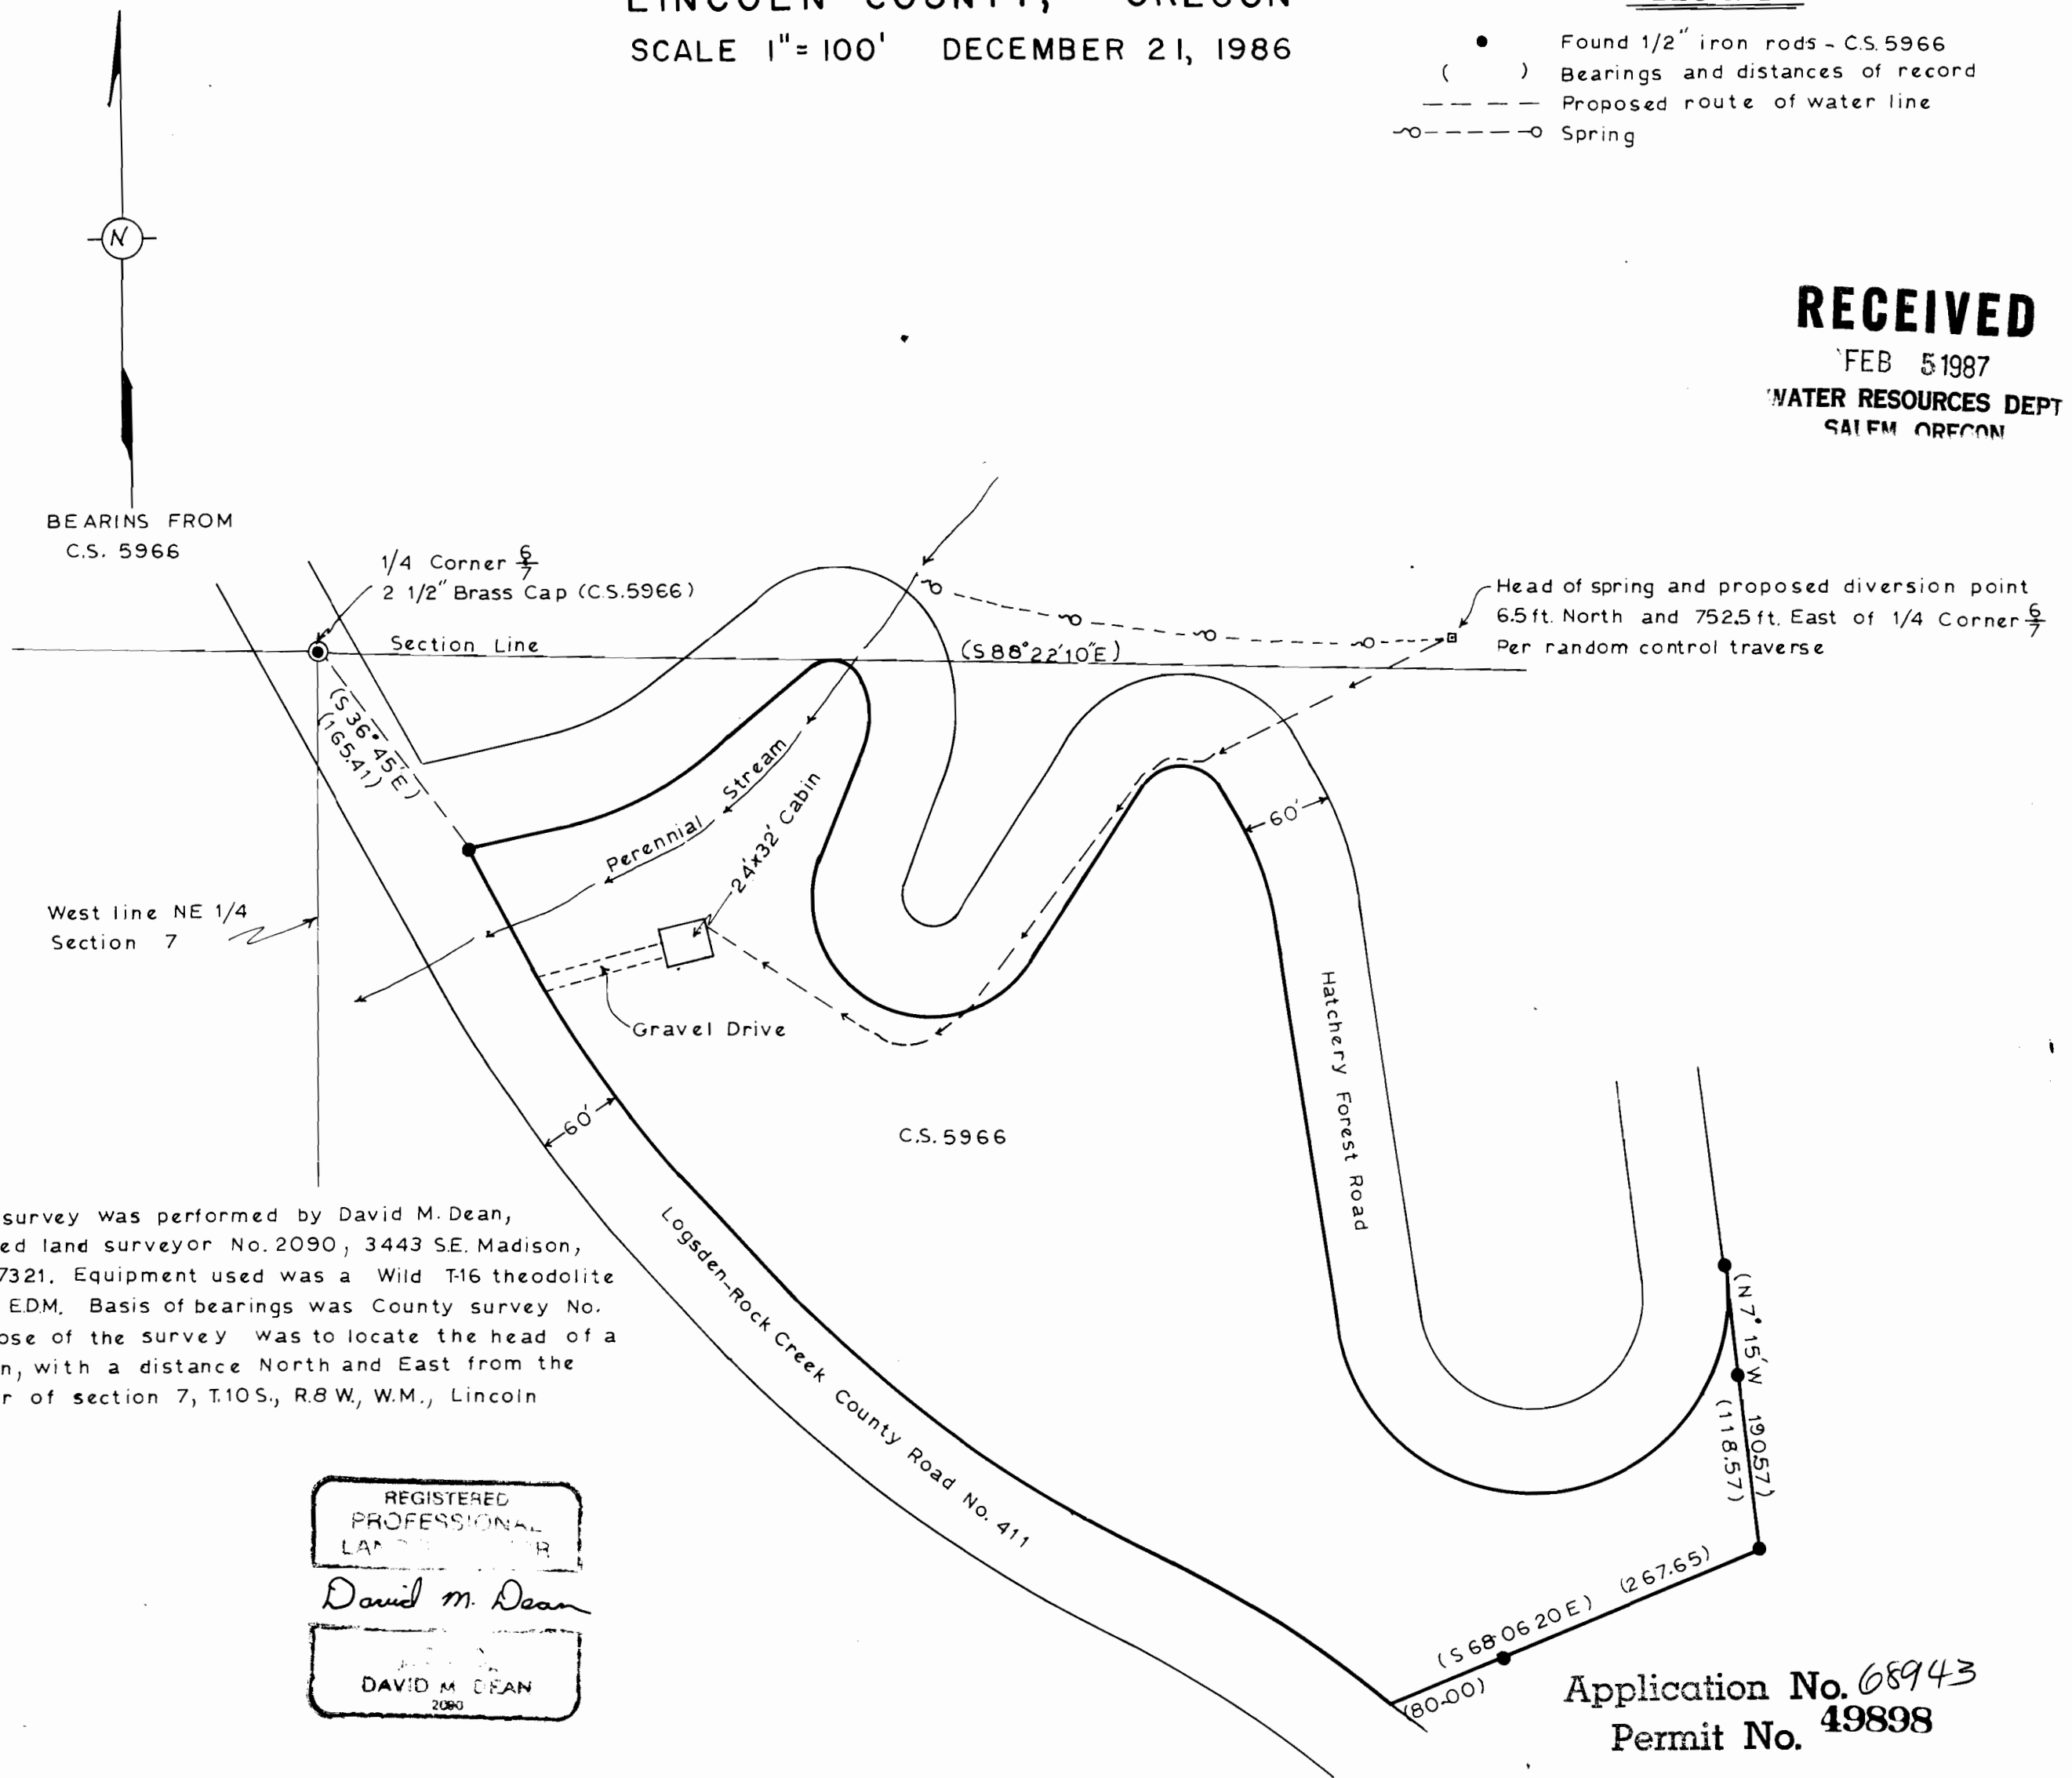

NARRATIVE: This survey was performed by David M. Dean, Oregon registered land surveyor No. 2090, 3443 SE. Madison, Albany, Oregon 97321. Equipment used was a Wild T-16 theodolite with a Wild DI-4 EDM. Basis of bearings was County survey No. 5966. The purpose of the survey was to locate the head of a spring as shown, with a distance North and East from the North 1/4 corner of section 7, T.10S., R.8W., W.M., Lincoln County, Oregon.

REGISTERED
PROFESSIONAL
LAND SURVEYOR

David M. Dean

DAVID M. DEAN
2090

Application No. 68943
Permit No. 49898