


T. 13 S., R. 11 W., W.M.

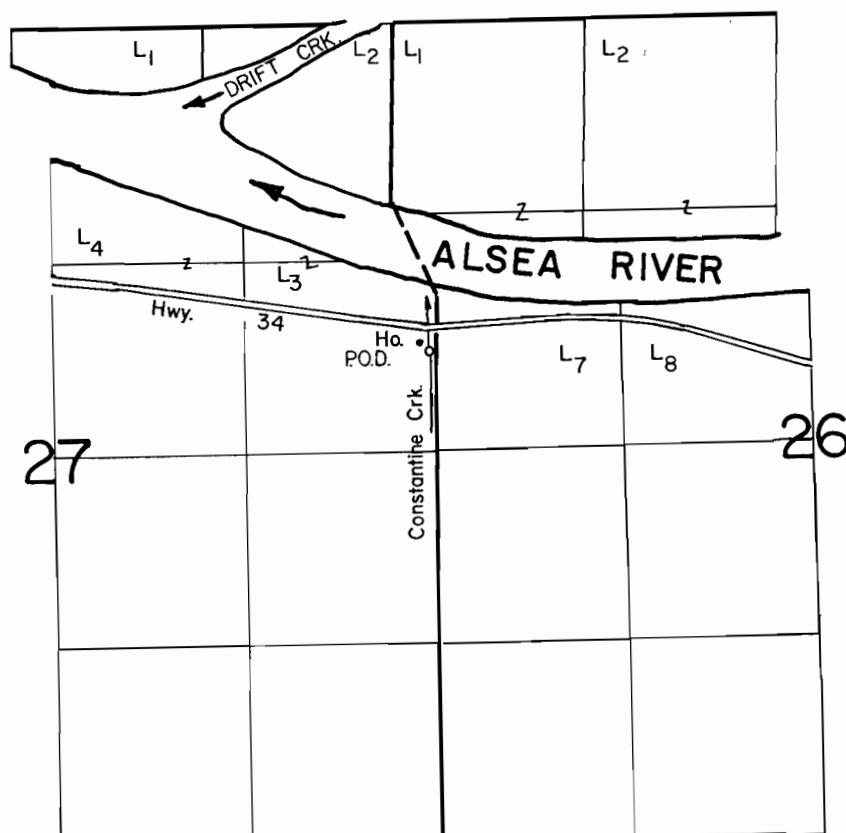

P.O.D. Loc. : 680' N. & 50' W. from E. 1/4 Cor. Sec. 27.

Scale: 1" = 1320'

FINAL PROOF SURVEY UNDER

Application No. 68959.. Permit No. 49978.....
IN NAME OF

MADGE L. FERRELL

Surveyed Sept. 20, 1989, by R. KLASSEN.....

41041-172-105
4/4/90 TMW