


T.13S. R.11W. W. M.

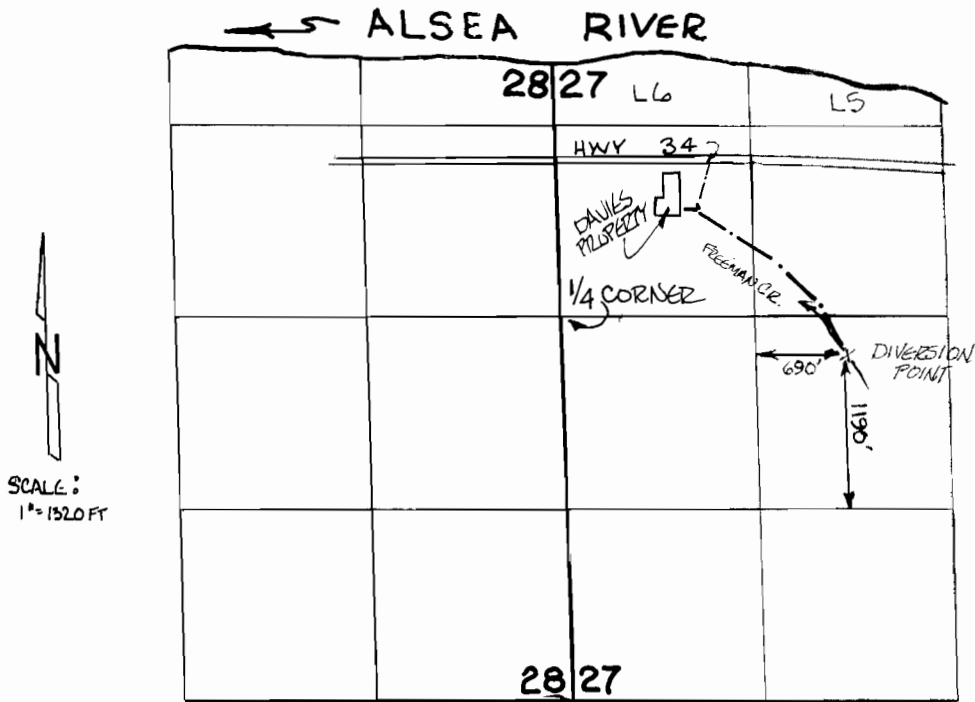

NOTE:
THE PURPOSE OF THIS MAP IS TO IDENTIFY THE LOCATION OF THE WATER RIGHT. IT IS NOT INTENDED TO PROVIDE INFORMATION RELATIVE TO THE LOCATION OF PROPERTY OWNERSHIP BOUNDARY LINES. —


FINAL PROOF SURVEY

UNDER

Application No. 69392 Permit No. 50201

IN THE NAME OF

FRANK DAVIES

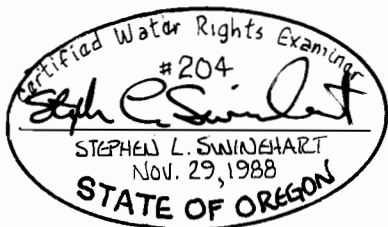

Surveyed JULY 13, 1989 By STEPHEN SWINEHART
C.W.R.E. #204
P.O. BOX 605
NEWPORT, OREGON
265-2343