

RECEIVED

A. R. = 11


T. 34 S., R. 1 W., W.M.  
Jackson County

WATER RESOURCES DEPT.  
SALEM, OREGON

S.E. 1/16

S. 1/16

THE PREPARATION OF THIS MAP WAS  
FOR THE PURPOSE OF IDENTIFYING THE  
WATER RIGHT ONLY & HAS NO INTENT TO  
PROVIDE DIMENSION OR LOCATION OF  
PROPERTY OWNERSHIP LINES.

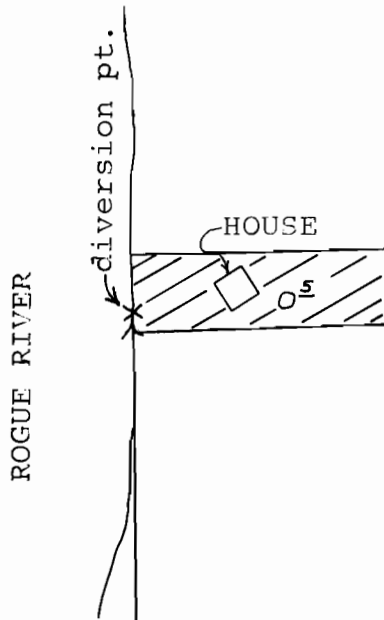


SE 1/4, SE 1/4



Scale: 1"=200'

920.4'

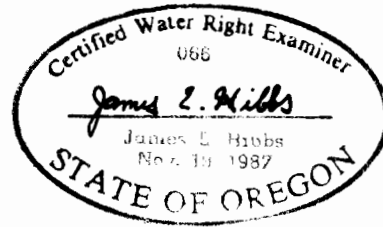

E. 1/16

1072.1'

S.21 S.22

S.28 S.27

FINAL PROOF MAP  
under

Application No. 69560 Permit No. 50416

IN NAME OF

EMIL & NANCY GEIGLE

Mapped Sept. 29, 1989 By L.J. Friar & Assoc.