




T. 38 S., R. 11 1/2 E., W.M.

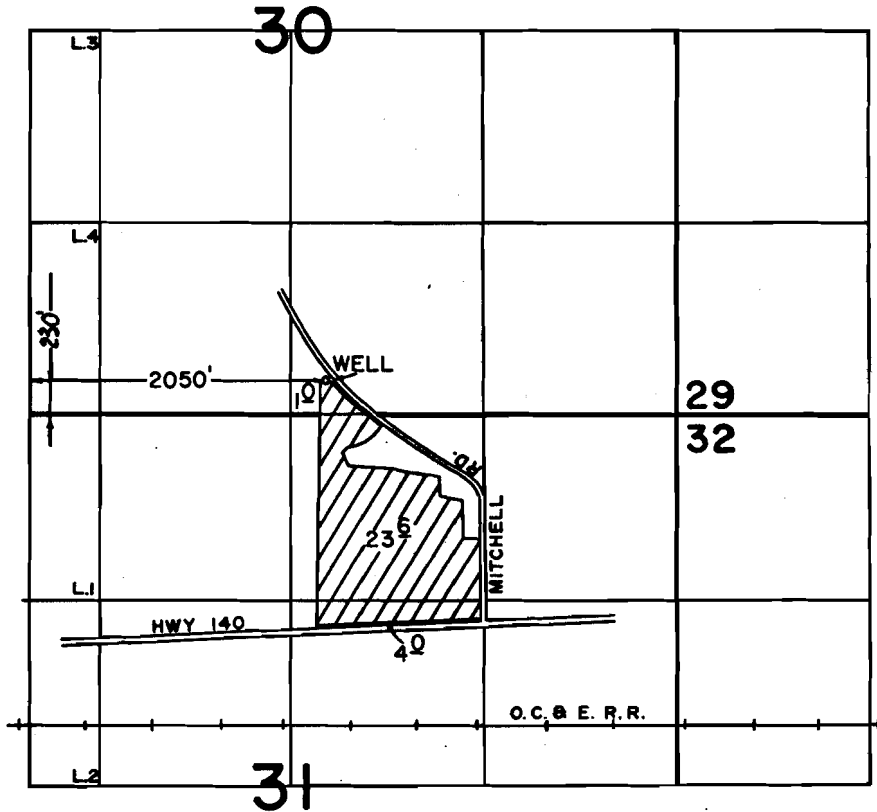

SCALE: 1" = 1320'

**FINAL PROOF SURVEY**  
UNDER

Application No. G-7481.. Permit No. G-7132....  
IN NAME OF

**MELVIN B. & MARJEANNE KANDALL**

Surveyed SEPT. 19. 1989., by B. W. BISHOP....

*Handwritten initials*