




T. 35 S., R. 6 W., W.M.

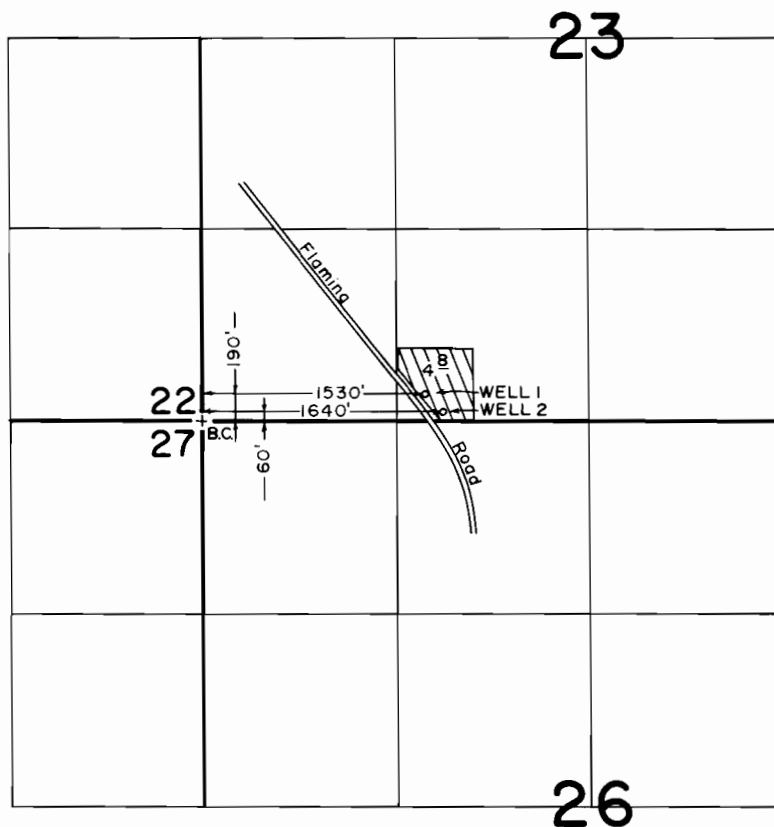

SCALE: 1" = 1320'

FINAL PROOF SURVEY UNDER

Application No. G-8218.. Permit No. G-7661.....
IN NAME OF

ARTHUR L. OAKES

Surveyed MAY 16... 1989, by ...B. S. JAMES....