


T. 6S., R. 39E., W. M.

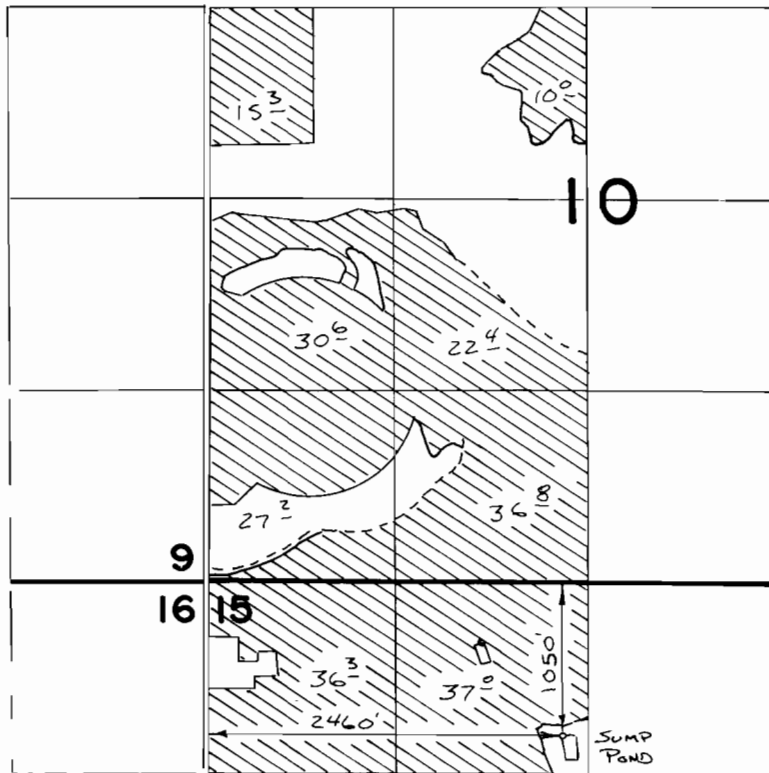

SCALE 1" = 1320'

**FINAL PROOF SURVEY**  
UNDER

Application No. **G:8498** Permit No. **G:7831**  
IN NAME OF

**MERLYN L. M'GARRY**

Surveyed *10-30* 19*89*, by *V. B. Church*