


# T. 39 S., R. 20 E., W.M.

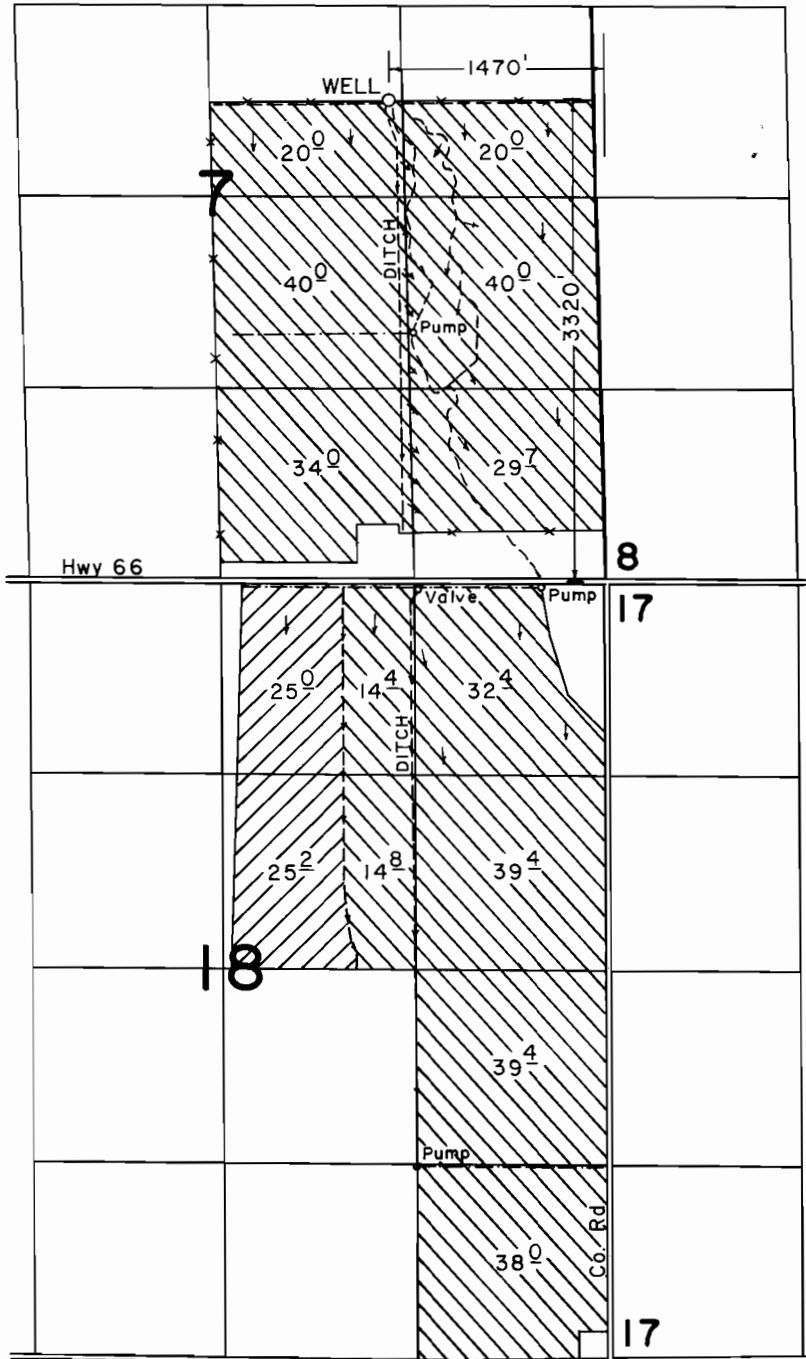

SCALE: 1" = 1320'



## FINAL PROOF SURVEY UNDER

 Primary

Application No. G-8536 Permit No. G-7922...  Suppl.  
IN NAME OF

DONALD O. & ORLO M. SHULLANBERGER

Surveyed AUG. 16. 1989, by B. W. BISHOP...