


T.28S., R.14W., W. M.

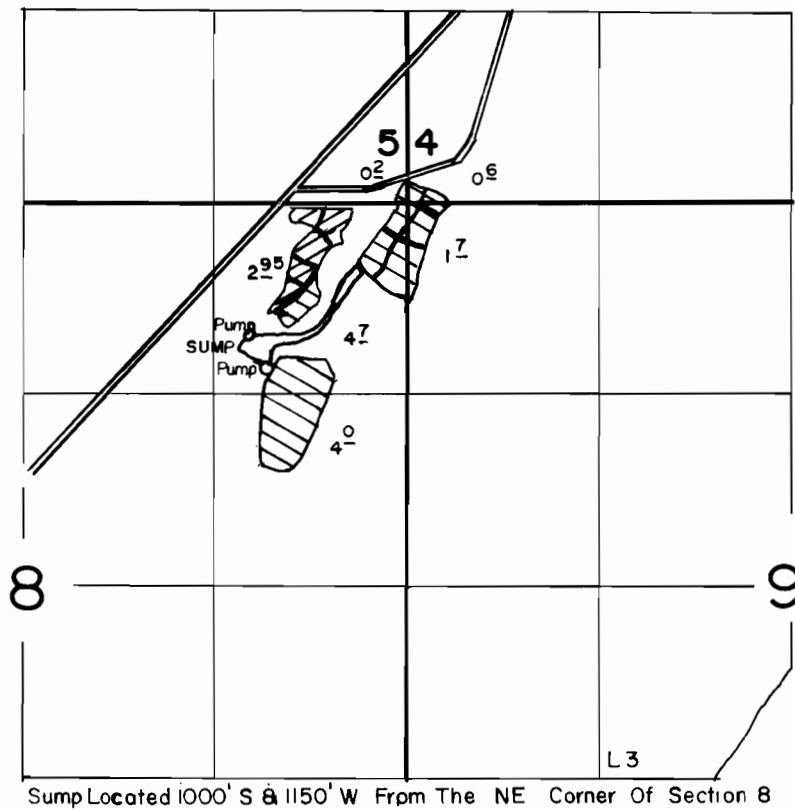

SCALE: 1" = 1320'

FINAL PROOF SURVEY
UNDER

Application No. G-8633... Permit No. G-8879.....
IN NAME OF

.....**HOWARD HULL**.....

Surveyed SEPT...19... 1989., by B.S. JAMES.....