


# T.37 S., R.2 E., W.M.

## SECTION 13

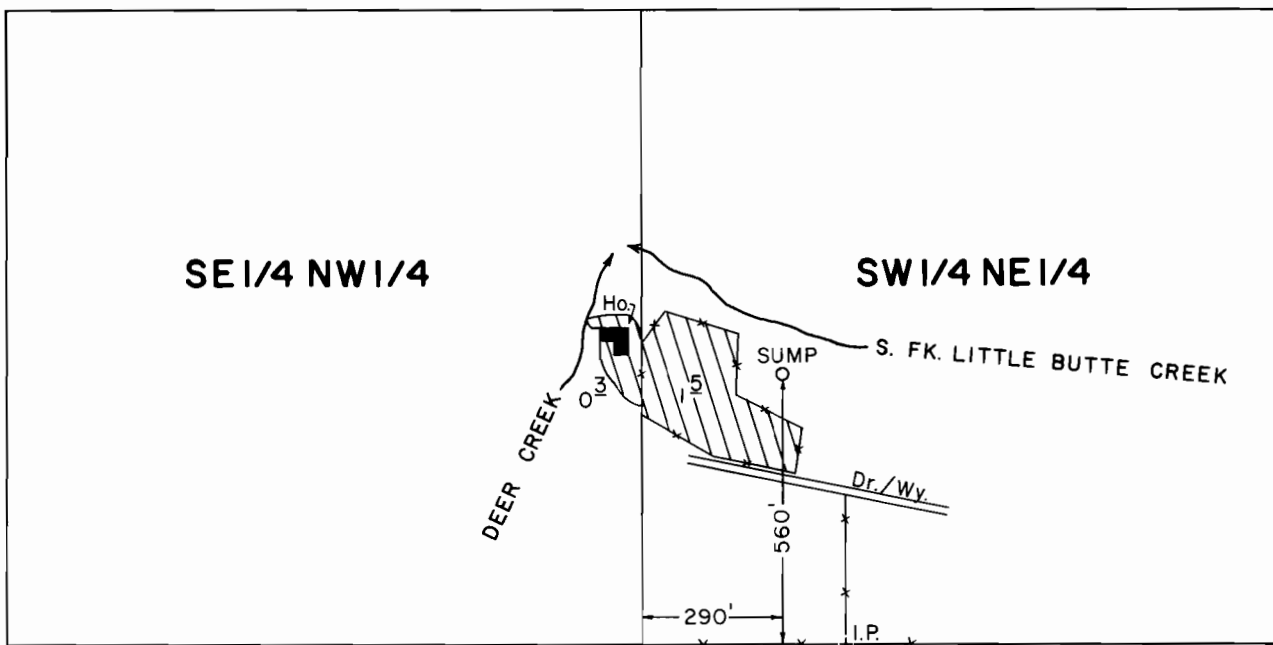

SCALE: 1" = 400'

### FINAL PROOF SURVEY UNDER

Application No. G-8755. Permit No. G-8105....  
IN NAME OF

**DANIEL F. WILKINS & GEORGINA ANN & ALICIA M. KENNEDY**

Surveyed JULY 19, 1989, by B. S. JAMES.....

12-12-89

PTS