


T.16S., R.16E., W.M.

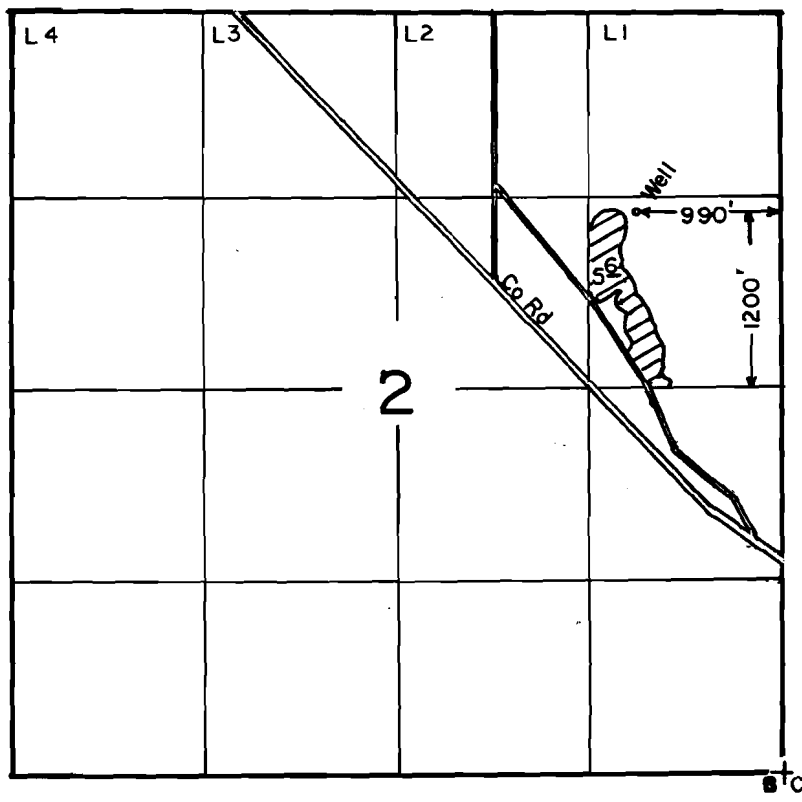

SCALE: 1"=1320'

FINAL PROOF SURVEY UNDER

Application No. G:8870.. Permit No. G:8260.....
IN NAME OF

.....**CHARLES H. FRANCE**.....

Surveyed JULY...17... 19.89., by L.L.CAREY.....

Cert. 65420

RECEIVED

DATE 3-29-91

WATER MASTER DISTRICT #11

BY DM