


# T.2S., R.2E., W.M.

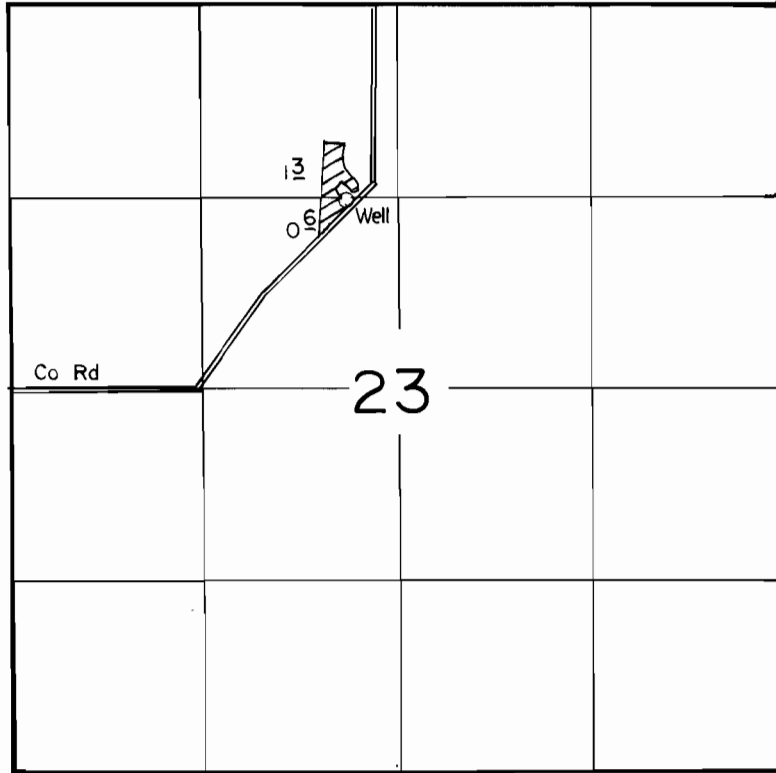

Well Located 1350' S & 350' W From The N1/4 Corner Of Section 23

SCALE: 1"=1320'

## FINAL PROOF SURVEY UNDER

Application No. G-9176... Permit No. G-8639.....  
IN NAME OF

.....**DAVID E. FLETCHER**.....

Surveyed AUG 15 1989, by R.W. KLASSEN.....