




T. 38 S., R. 11 1/2 E., W.M.

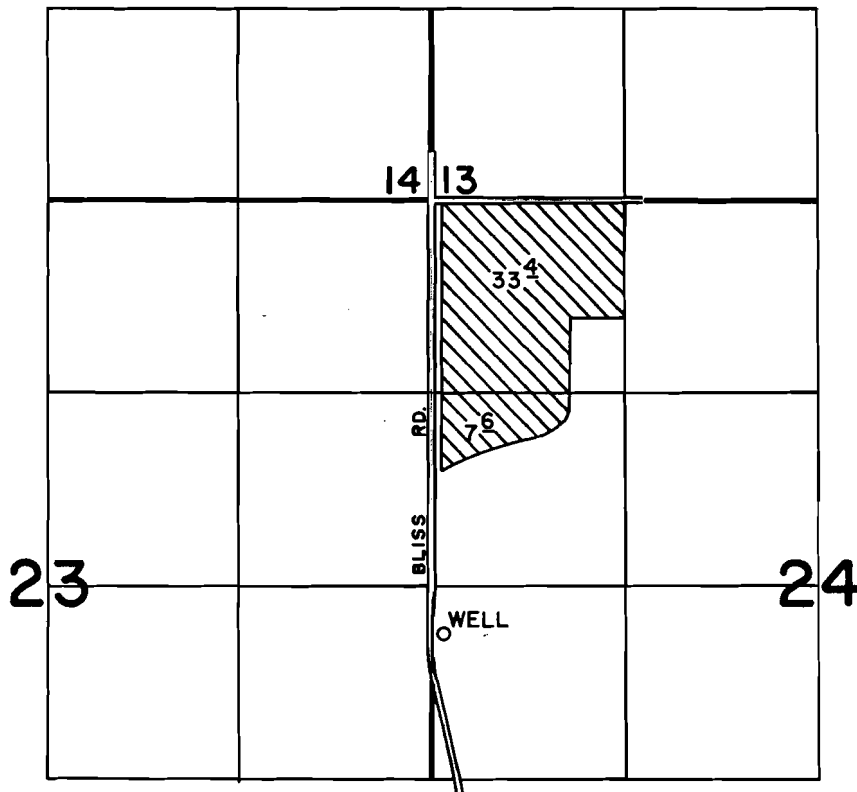

WELL LOC.: 2960' S. & 85' E. FROM NW CORNER SECTION 24

SCALE: 1" = 1320'

FINAL PROOF SURVEY UNDER

Application No. G-9427 Permit No. G-8782...
IN NAME OF

..... JOHN F. HORTON

Surveyed SEPT. 21, 1989, by B. W. BISHOP.....

Butt Ck. & Young Valley Wells