




T. 38 S., R. 2 E., W.M.

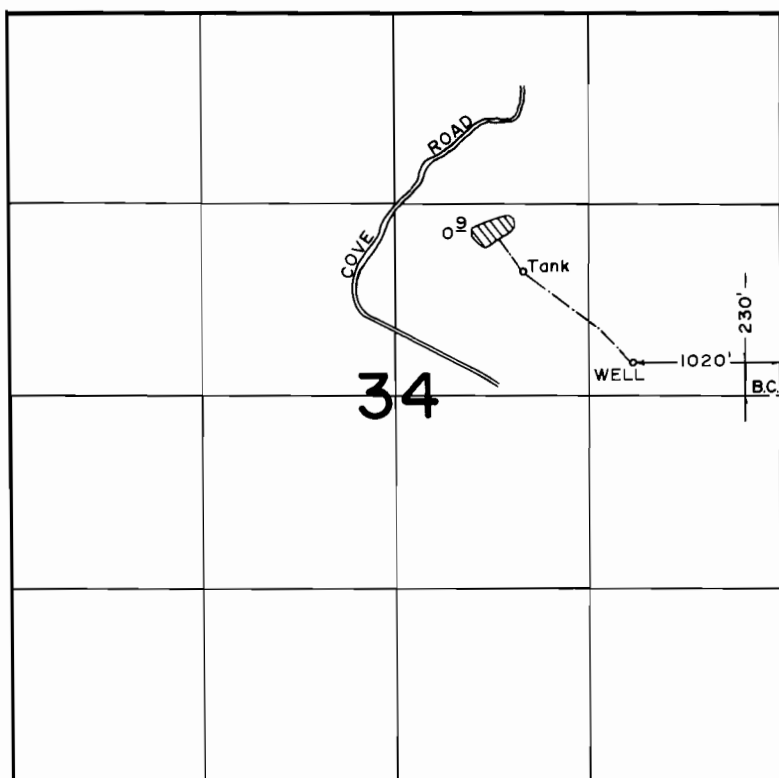

SCALE: 1" = 1320'

FINAL PROOF SURVEY
UNDER

Application No. G-10581 Permit No. G-9705
IN NAME OF

RAY F. & DOROTHY L. MITCHELL

Surveyed SEPT. 7, 1989, by B. S. JAMES