




T. 16 S., R. 16 E., W.M.

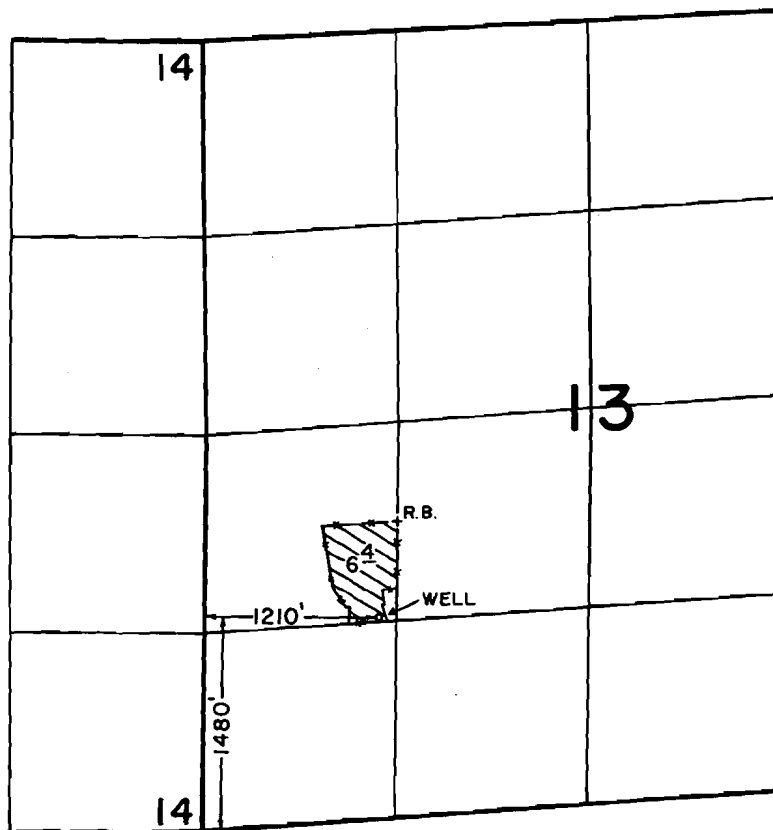

SCALE: 1" = 1320'

FINAL PROOF SURVEY
UNDER

Application No. G-10652 Permit No. G-9902....
IN NAME OF

SYLVIA WHITMORE

Surveyed SEPT. 7, 1989, by B.W. BISHOP

Cert. 65427

RECEIVED

DATE 3-29-91

WATER MASTER DISTRICT #11

BY

BWB

2-26-90
PTS

fw

G-9902