


T.6S.R.38E.W.M.

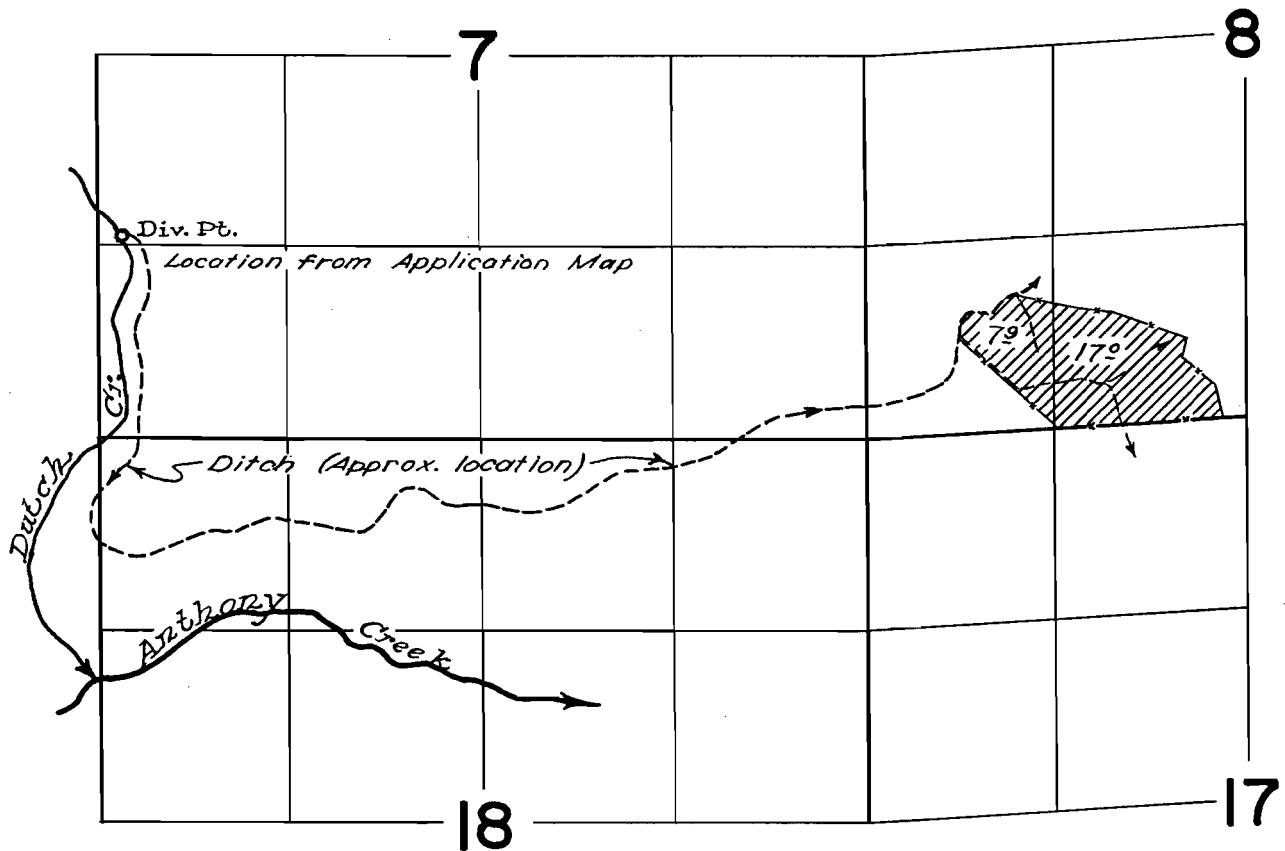

FINAL PROOF SURVEY
UNDER

Application No. 31370..... Permit No. 24734..
IN NAME OF

.....MARY K. CHRISTMAN.....

Surveyed Sept. 27 1963, by C. R. Baker..