




T.37 & 38 S., R.11 1/2 E., W.M.

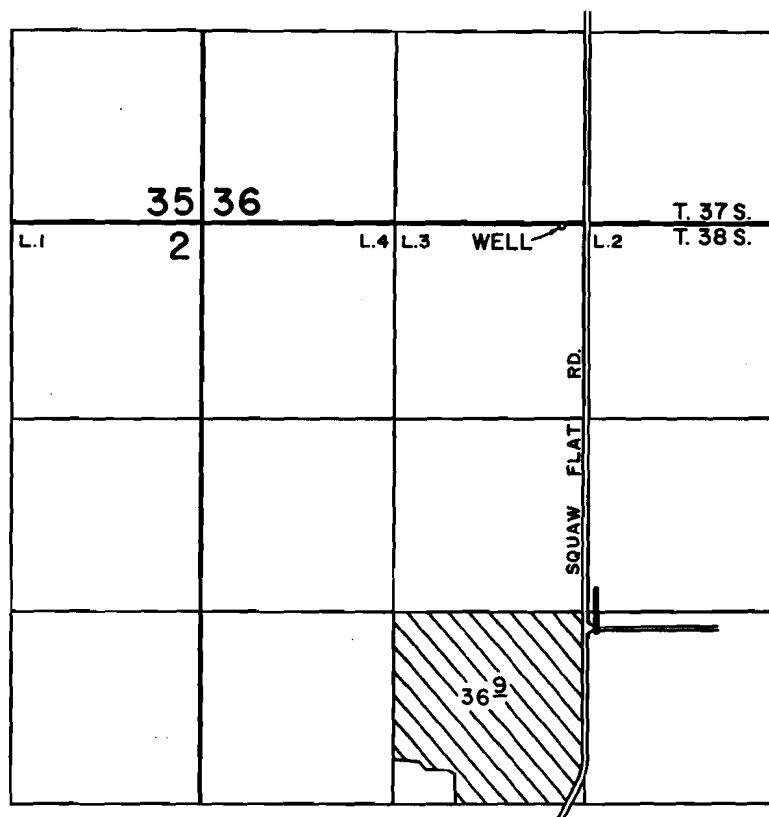

WELL LOC.: 10' S. & 160' W. FROM N.1/4 CORNER SECTION 1

SCALE: 1" = 1320'

FINAL PROOF SURVEY

UNDER

Application No. G-11363. Permit No. G-10497.
IN NAME OF

RICHARD E. WALKER

Surveyed SEPT. 18, 1989, by B.W. BISHOP