


T. 1 S., R. 4 E., W. M.

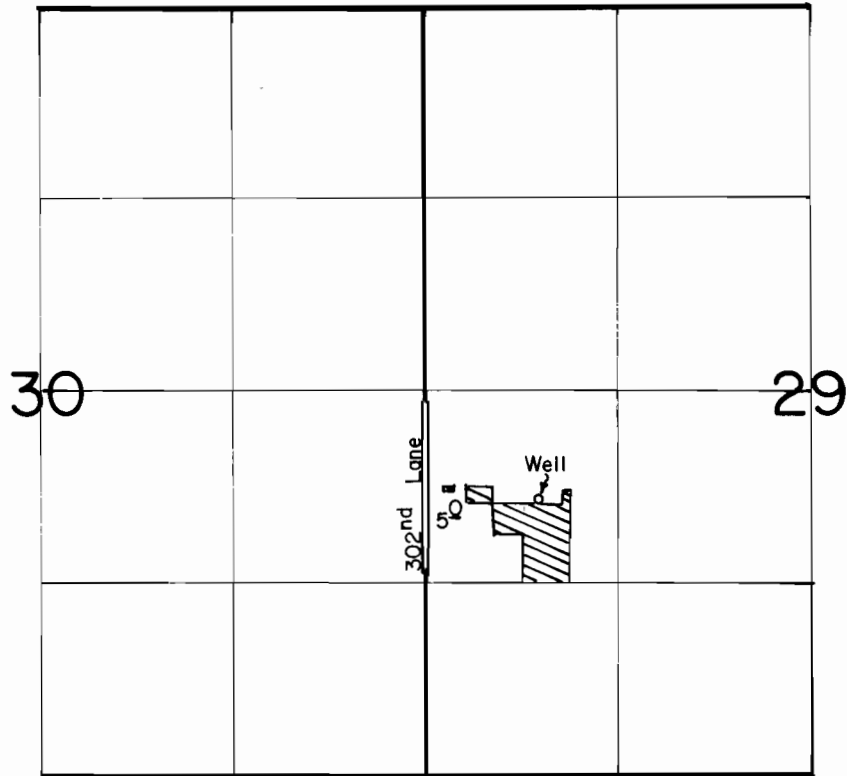

Well Loc.: 750' S. & 780' E. from W. 1/4 Cor. Sec. 29.

Scale: 1" = 1320'

FINAL PROOF SURVEY
UNDER

Application No. G-11381. Permit No. G-10541...
IN NAME OF

.....PHIL VAN HISE.....

Surveyed Nov. 3, 1989, by T. Warren.....

41005-270-53A
4/11/90 TAW