


T.5S., R.1W., W.M.

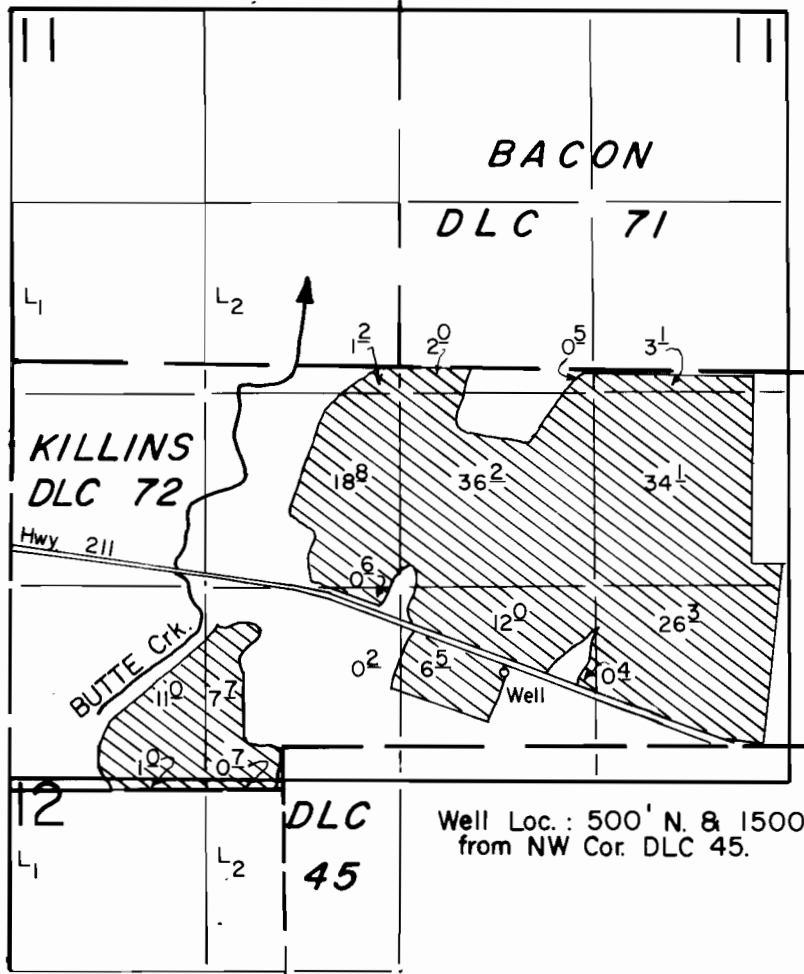

Scale: 1" = 1320'

Well Loc.: 500' N. & 1500' E.
from NW Cor. DLC 45.

FINAL PROOF SURVEY UNDER

Application No. G-11420 Permit No. G-10523
IN NAME OF

Lloyd M. Campbell

Surveyed Dec. 20, 1989, by J. Warren