


T. 32 S., R. 5 W., W. M.

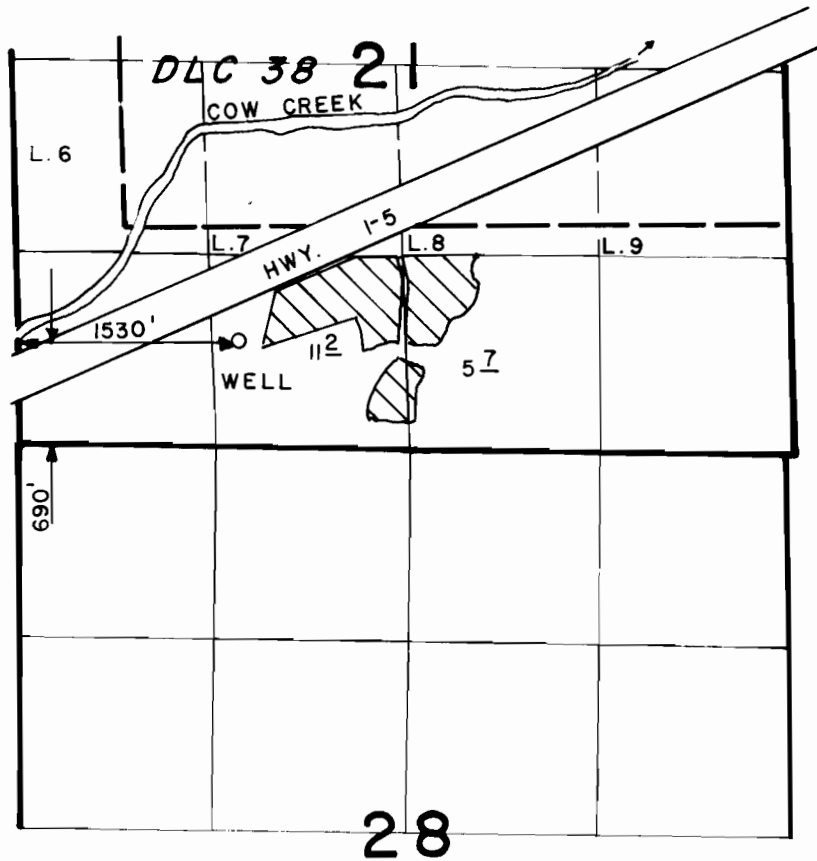

SCALE: 4" = 1 MILE

FINAL PROOF SURVEY
UNDER

Application No. G-11482²⁹ Permit No. G-10577
IN NAME OF

EUGENE M. REEDER

Surveyed JULY 12, 1989, by J. M. SCHMORDE.