


T. 1 S., R. 4 E., W.M.

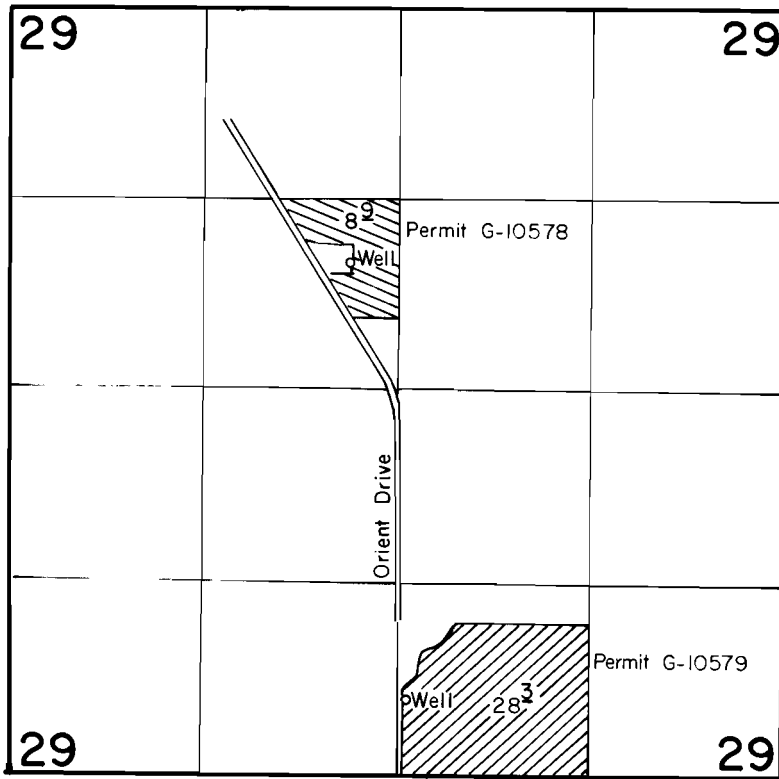

Permit G-10578 Well Loc.: 860' N. & 340' W. from C-1/4 Cor. Sec. 29.
 Permit G-10579 Well Loc.: 520' N. & 60' E. from S-1/4 Cor. Sec. 29.

Scale: 1" = 1320'

FINAL PROOF SURVEY UNDER

Application No. ~~G-11430~~ ^{G-11430} Permit No. ~~G-10578~~ ^{G-10578}
 IN NAME OF

NAPPE & SON NURSERY, INC.

Surveyed Nov. 29, 1989, by T. Warren