


See Map TRANSF 7602
in Transfer Map Book



T. 39 S., R. 8 E., W.M.

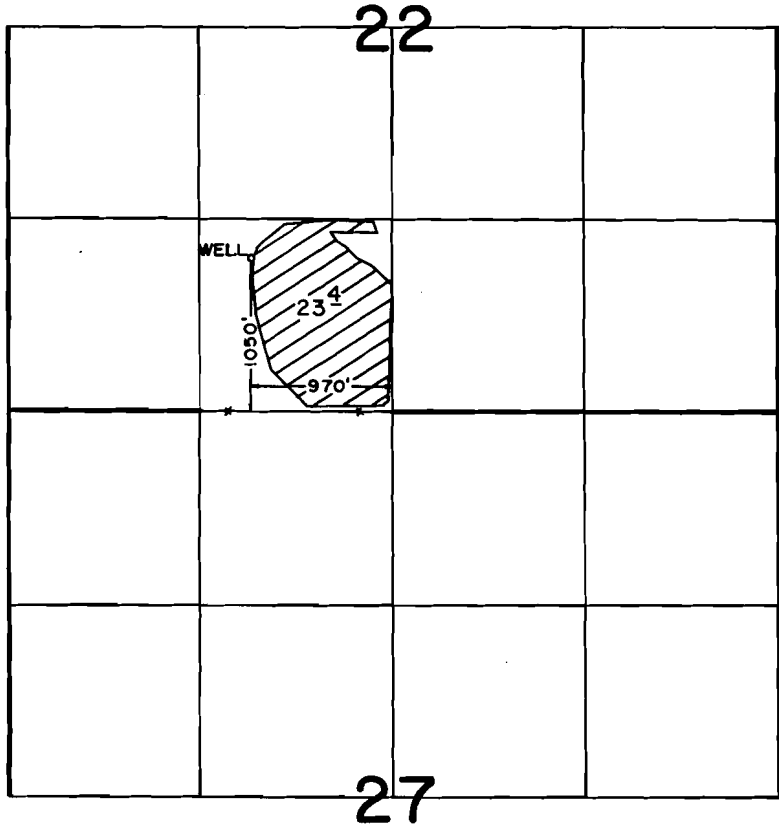

SCALE: 1" = 1320'

FINAL PROOF SURVEY
UNDER

Application No. G-11544 Permit No. G-10653...
IN NAME OF

BEN L. CORNELIUS

Surveyed JUNE 14, 1989, by B.W. BISHOP