


T. 1 S., R. 4 E., W.M.

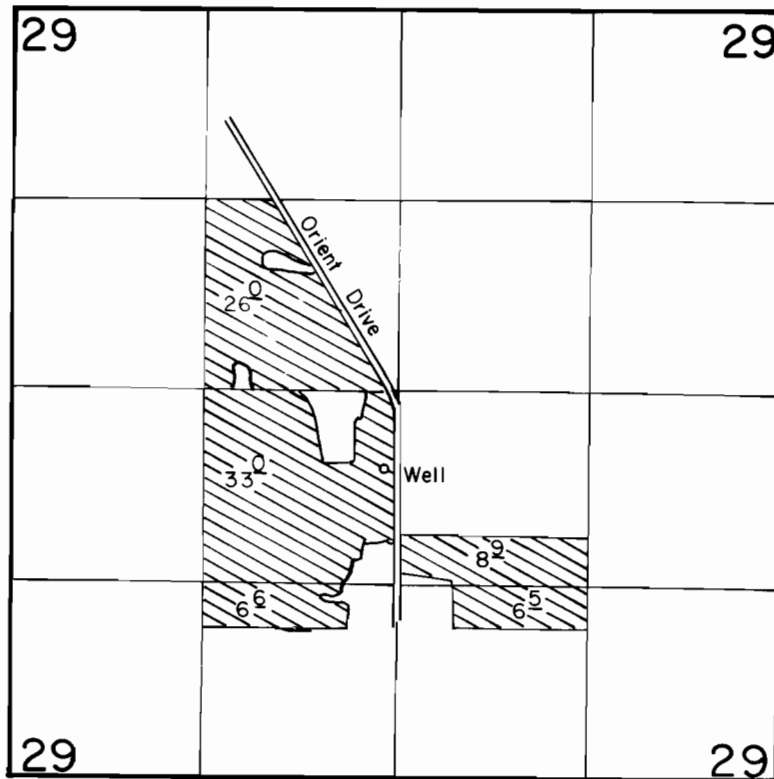

Well Loc. : 520' S. & 90' W. from C-1/4 Cor. Sec. 29.

Scale : 1" = 1320'

FINAL PROOF SURVEY UNDER

Application No. G-11545 Permit No. G-10783..
IN NAME OF

DAN LEWIS NELSON.....

Surveyed Nov. 3, 1989, by T. Warren.....

41005-278-53A
4/11/90 TMW