


T. 1 N., R. 3 W., W.M.

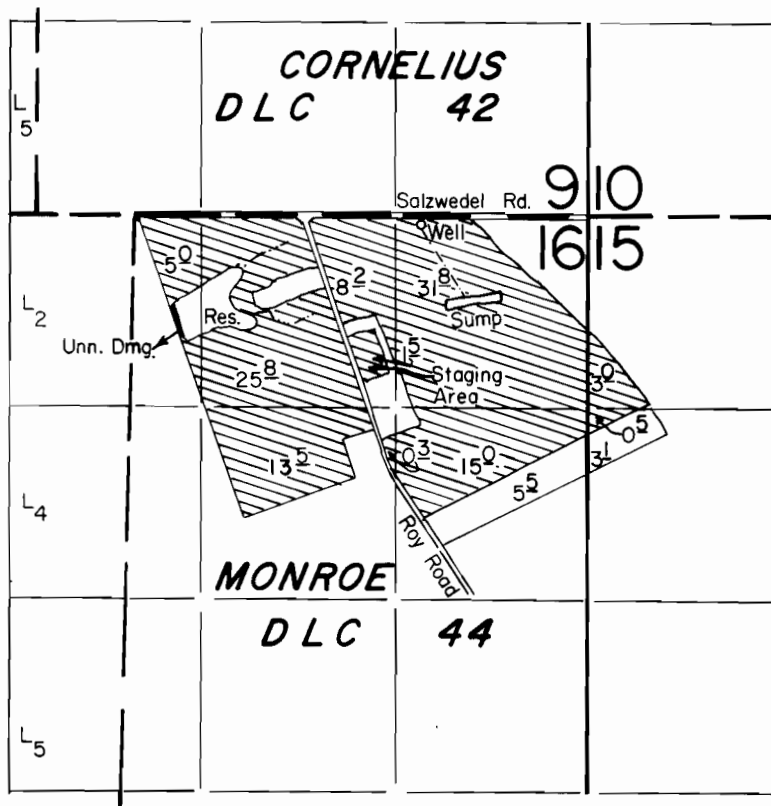

Well Loc.: 50' S. & 1140' W. from NE Cor. Sec. 16

Scale: 1" = 1320'

FINAL PROOF SURVEY UNDER

Application No. G-11556. Permit No. G-10656...
IN NAME OF

MAPLE HEADQUARTERS, NW

Surveyed JULY 10, 1989, by T. Warren