


T. 36 S., R. 7 W., W. M.

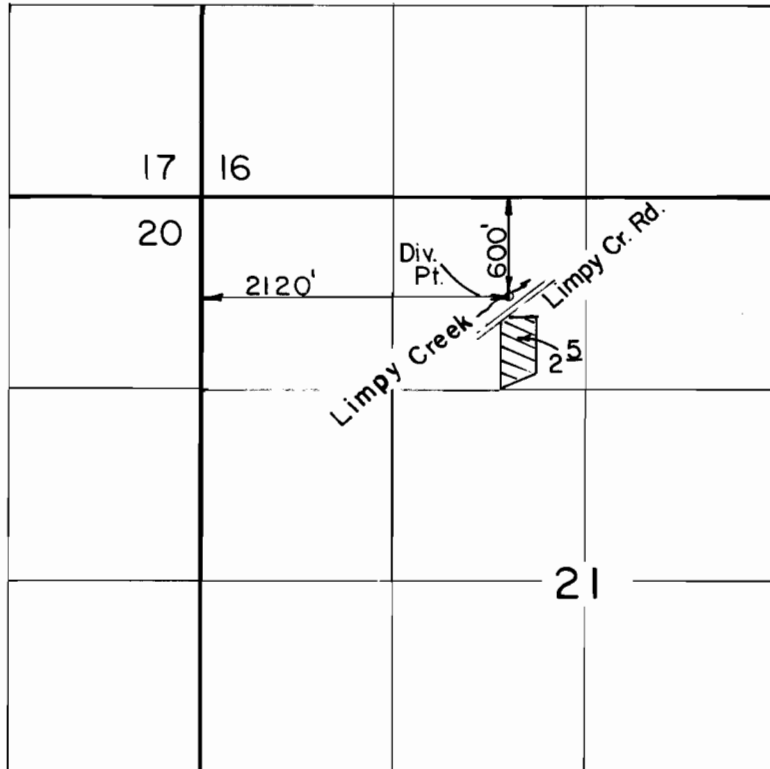

Scale: 1" = 1320'

FINAL PROOF SURVEY UNDER

Application No. 49274 Permit No. 36928...
IN NAME OF

EDMUND & INGER M. WITTMANN

Surveyed AUG. 31, 1988, by B. S. JAMES...