


T. 21 S., R. 1 W., W.M.
SECTION 34

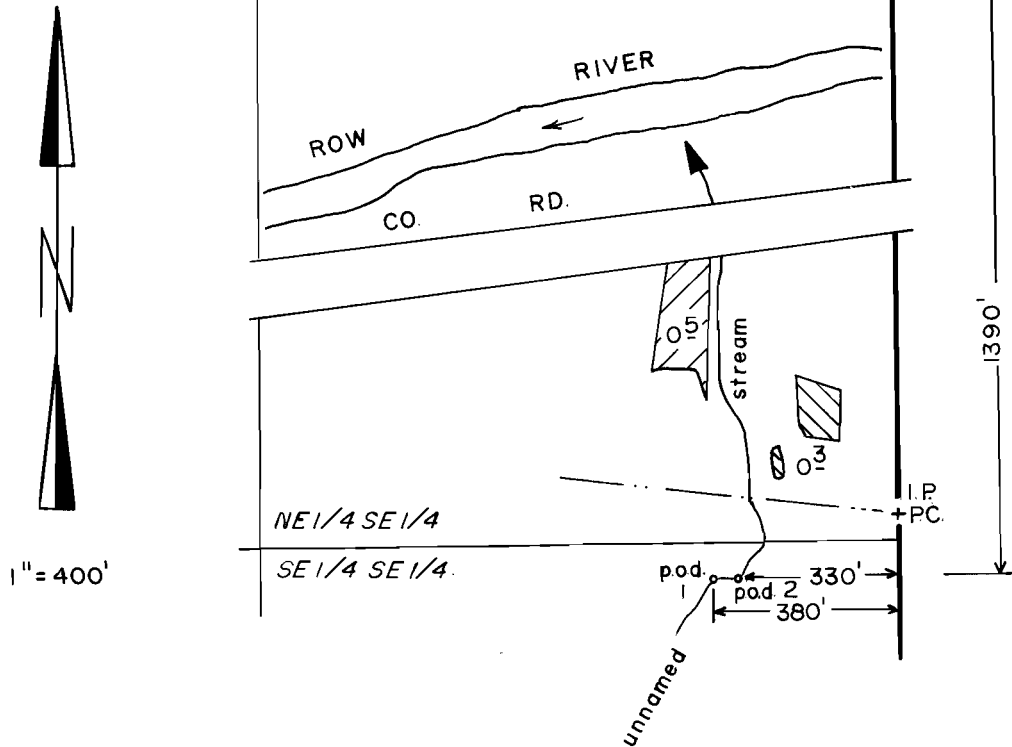

FINAL PROOF SURVEY
UNDER

Application No. 50833 Permit No. 38380.....
IN NAME OF

EDWARD WARREN CARDWELL

Surveyed JUNE 5 1990, by T.M. WARREN

8-9-90 DSM
P.T.S.