


T.19S. R.1E. W.M.

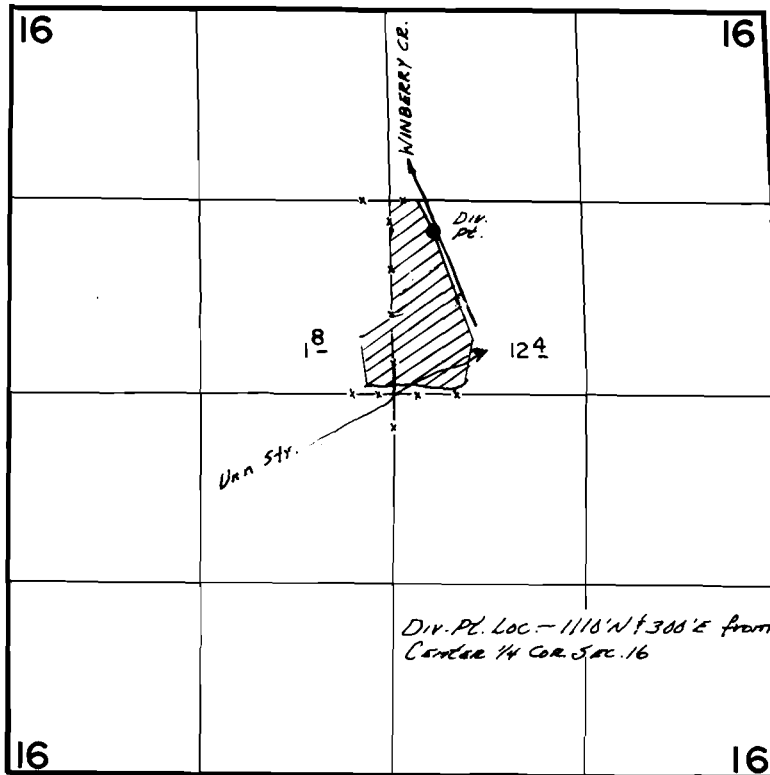

SCALE: 1" = 1320'

FINAL PROOF SURVEY UNDER

Application No. 54139... Permit No. 40530....
IN NAME OF

.....JAMES HERMAN SIEMINSKI.....

Surveyed June 29 1979, by S.C. BROWN.....
JUNE 12 1990 T M WARREN

REVISED 8-8-90 DLM

PTS-1979-B 600