


T. 1 S., R. 38 E., W. M.

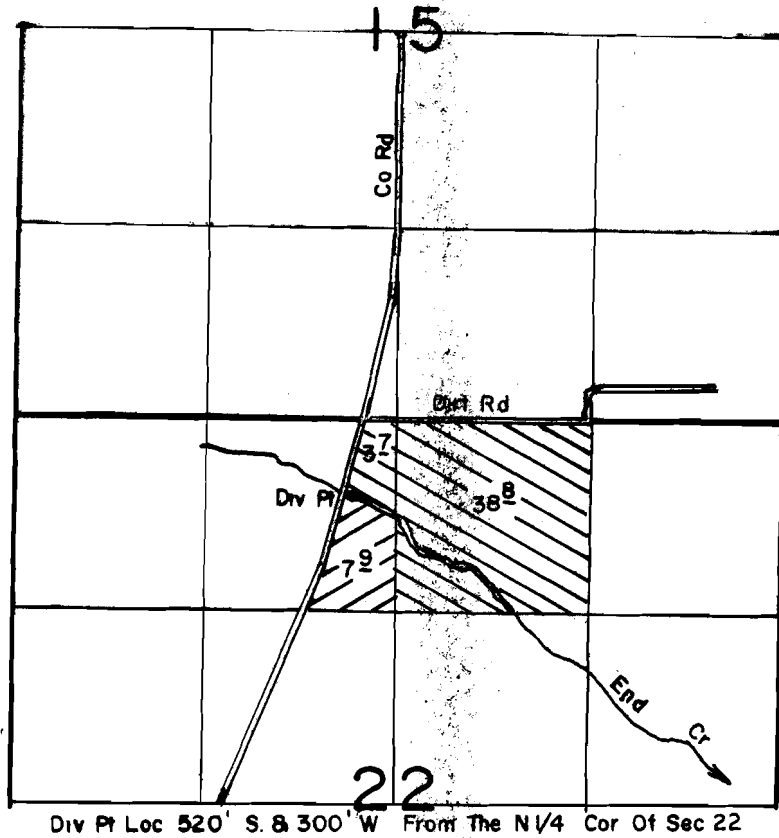

 Primary
 Supplemental

SCALE: 1"=1320'

FINAL PROOF SURVEY
UNDER

Application No. 55797..... Permit No. 42206.....
IN NAME OF

.....**REBECCA A. PRESTON**.....

Surveyed JULY...12.. 1989.. by V. L. CHURCH.....