


T. 15 S., R. 11 W., W.M.

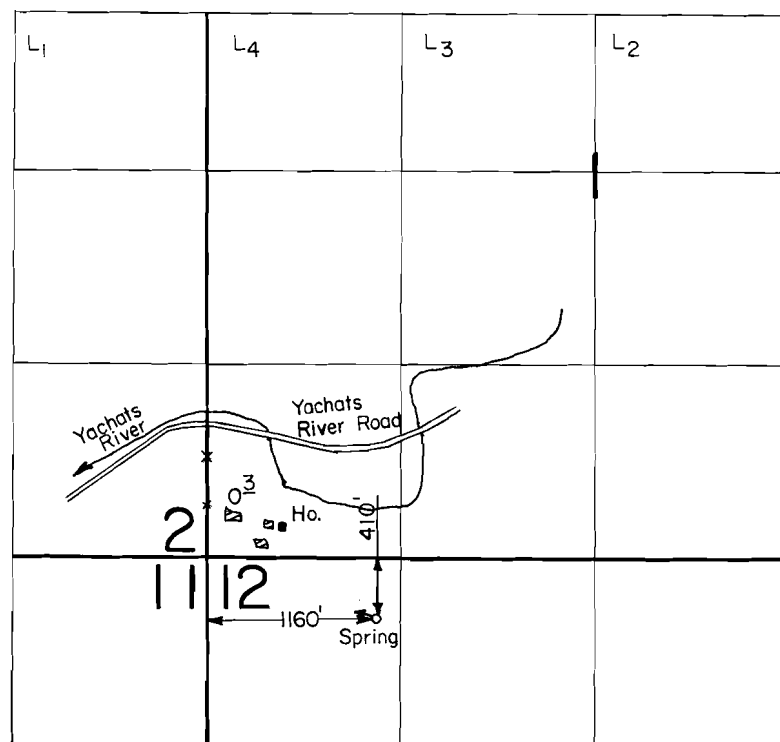

Scale : 1" = 1320'

FINAL PROOF SURVEY UNDER

Application No. 57811... Permit No. 43602.....
IN NAME OF

...RICHARD A. SPRINGSTEEN

Surveyed Nov. 16... 1989., by ...T. Warren.....