


7-28-88  
65444

T. 39S., R. 9E., W.M.

Klamath River

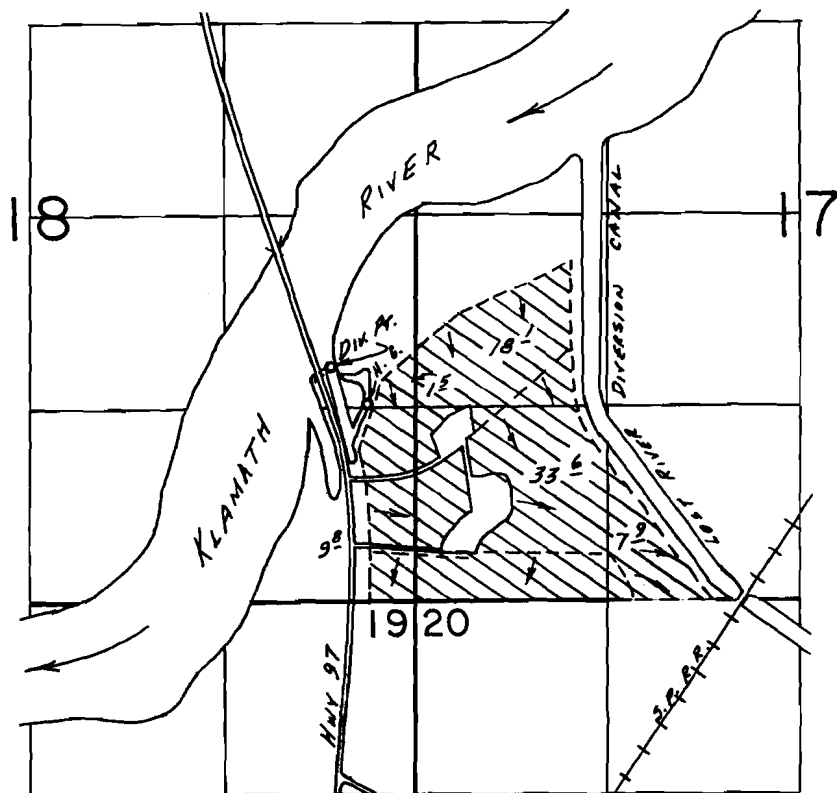

DIV. PT. LOC.: 1600' N. F 600' W. FROM SE COR. SEC. 18

SCALE: 1" = 1320'

### FINAL PROOF SURVEY UNDER

Application No. 58065.. Permit No. 43883.....  
IN NAME OF

.....CALVIN L. HUNT.....

Surveyed July 21, 1988, by B.W. BISHOP.....

12/1/89  
BWB