


T.5S., R.40E., W.M.

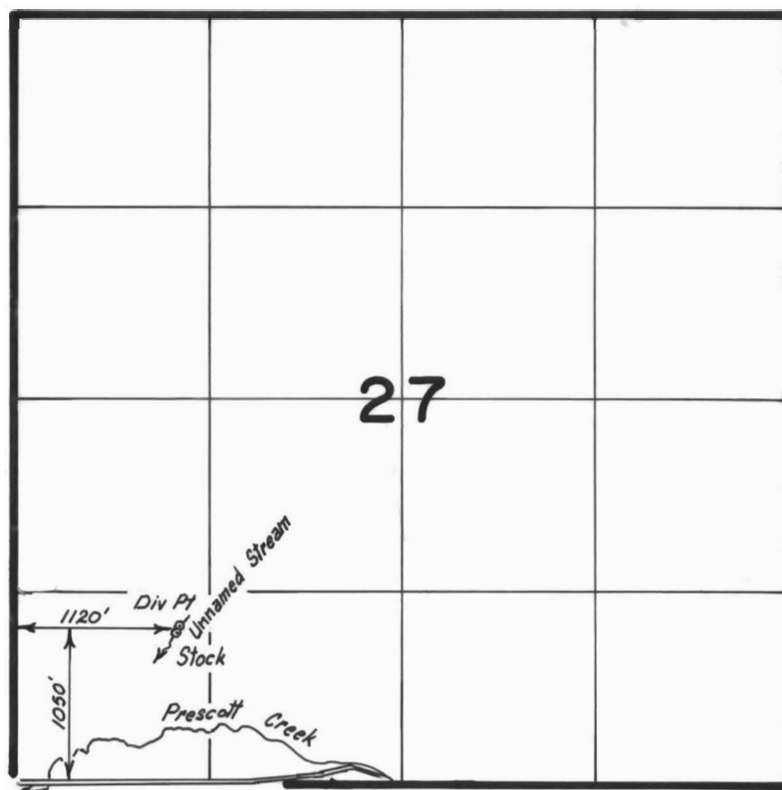

FINAL PROOF SURVEY
UNDER


Scale: 1" = 1320'

Application No. **58500** Permit No. **44109**
IN NAME OF

MILDRED B. MORRIS

Surveyed **6-9** 1988, by **Vern Church**