

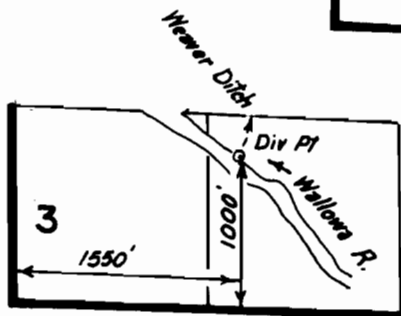


# T.1N., R.42E., W.M.

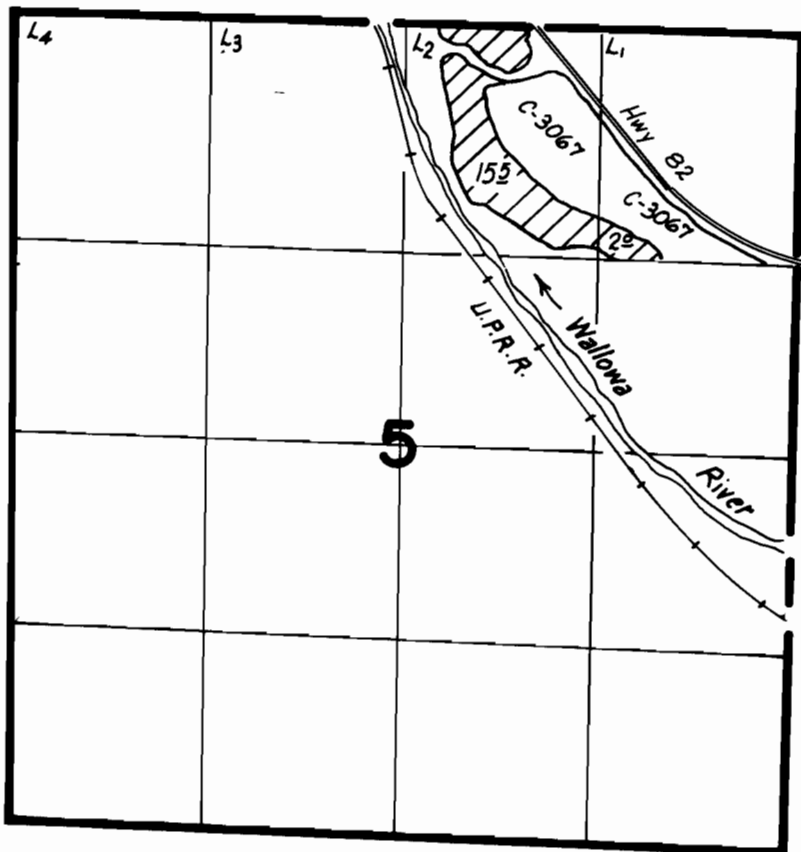

## FINAL PROOF SURVEY UNDER

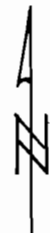

Scale: 1" = 1320'

Application No. **58630**. Permit No. **44749**...  
IN NAME OF

.....**HOWARD M. JOHNSON**.....

Surveyed ..**8-8**..... 19**88**., by *Vern. Church*.....

BBA - IMM - 138  
41063 - 179 - 149R

KK 3/89