


T. 35 S., R. 14 W., W. M.

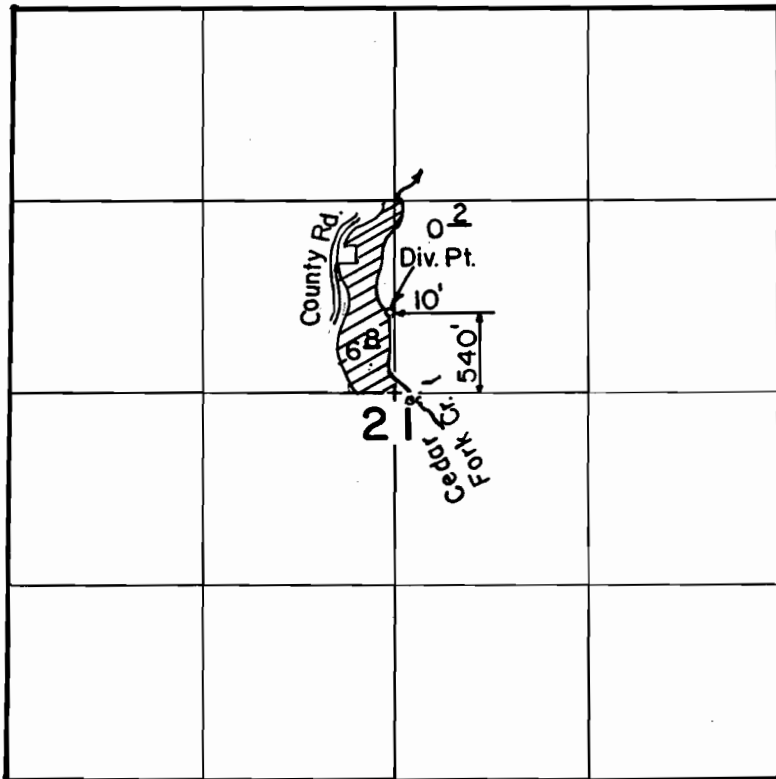

Scale: 1" = 1320'

FINAL PROOF SURVEY
UNDER

Application No. ~~58987~~. Permit No. ~~44496~~..
IN NAME OF
GAROLD M. & LOIS EMERSON

Surveyed JUL. 22, 1988, by B. S. JAMES