


T. 37 & 38 S., R. 6 W., W. M.

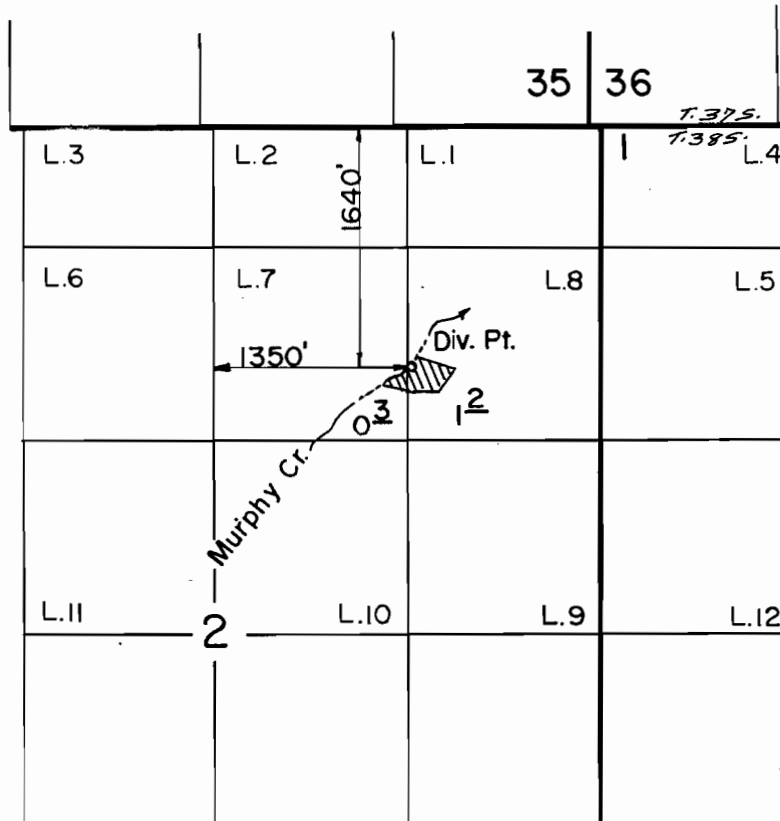

Scale : 1" = 1320'

FINAL PROOF SURVEY UNDER

Application No. 58858 Permit No. 44365
IN NAME OF

ERNEST J. CROTEAU

Surveyed MAY 24, 1988, by B. S. JAMES