


T. 36 S., R. 7 W. W. M.

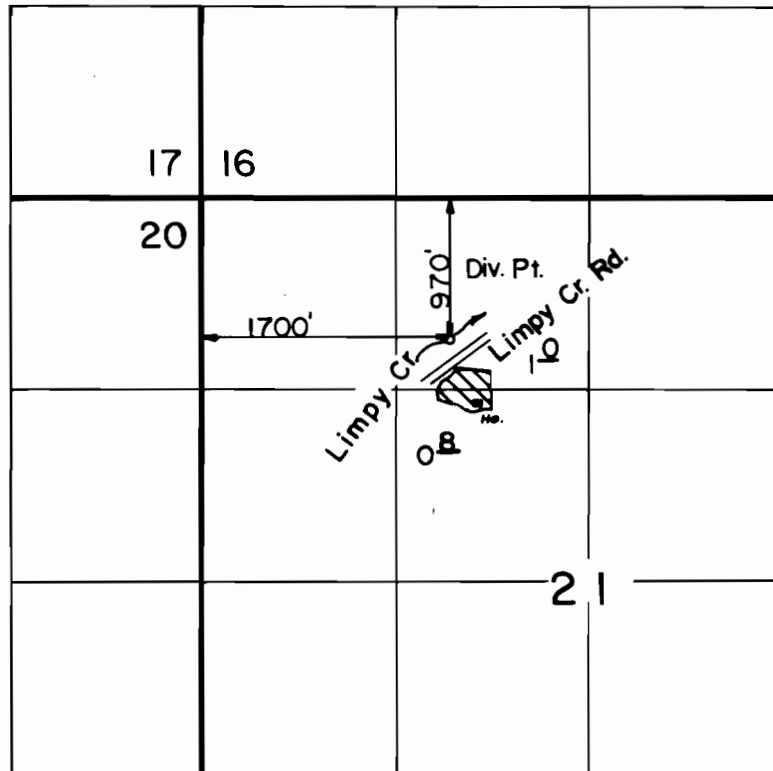

Scale: 1" = 1320'

FINAL PROOF SURVEY
UNDER

Application No. 59206 Permit No. 44480
IN NAME OF

.....DONALD F. BERRY.....

Surveyed Sept. 1, 1988, by B. S. JAMES.....