


T. 28 S., R. 13 W., W.M.

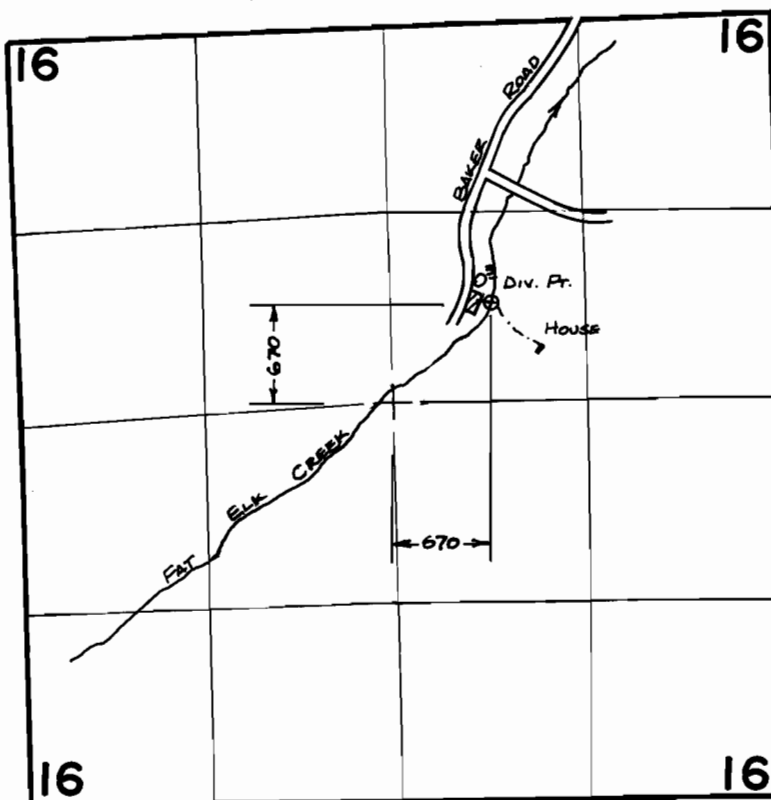

SCALE : 4" = 1 MILE

FINAL PROOF SURVEY UNDER

Application No. ..59284. Permit No. ...44649....
IN NAME OF

.....**JOHN A. UNRUH**.....

Surveyed ...3/16.... 19.88, by ...**M. SCHMORDE**...