


T. 36 S. R. 6 W., W. M.

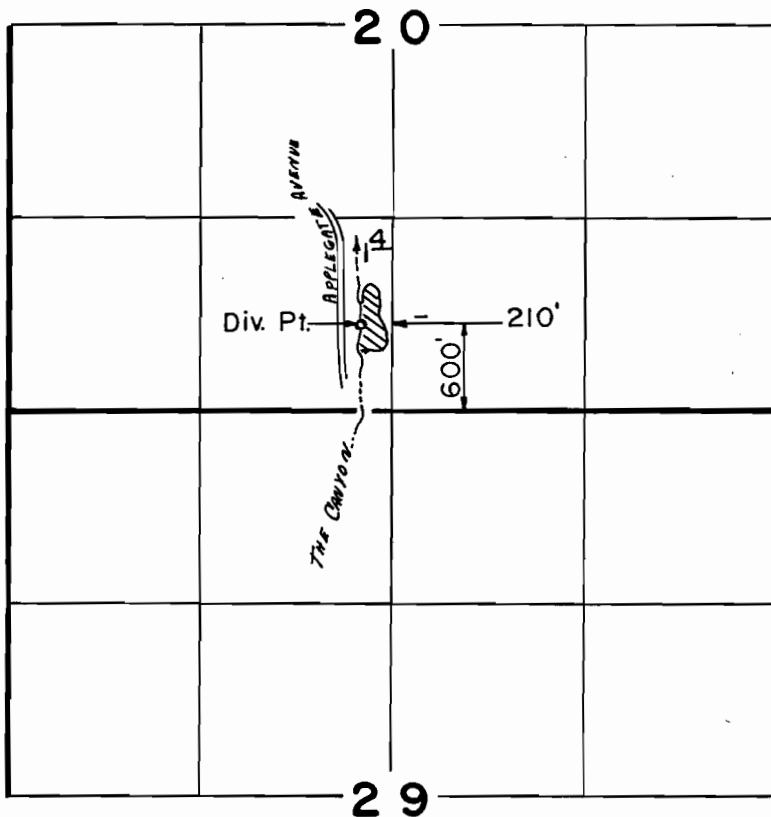

Scale: 1" = 1320'

FINAL PROOF SURVEY
UNDER

Application No. 59303. Permit No. 44756...
IN NAME OF

..RONALD... & ...ANN... PADGETT...

Surveyed AUG. 30. 1988, by .B... S... JAMES...