


T.37S.,R.2E.,W.M.

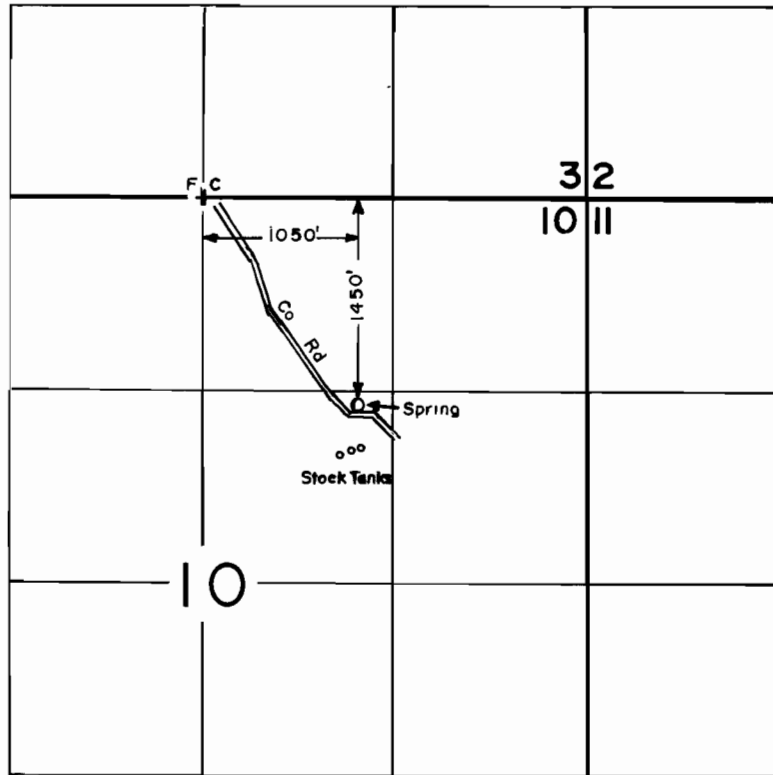

SCALE: 1"=1320'

FINAL PROOF SURVEY
UNDER

Application No. 59.808.. Permit No. 4538.0.....
IN NAME OF

.....**GERALD W. HANSEN**.....

Surveyed JULY..18... 1989., by B.S.JAMES.....