


T. 28 S., R. 5 W., W. M.

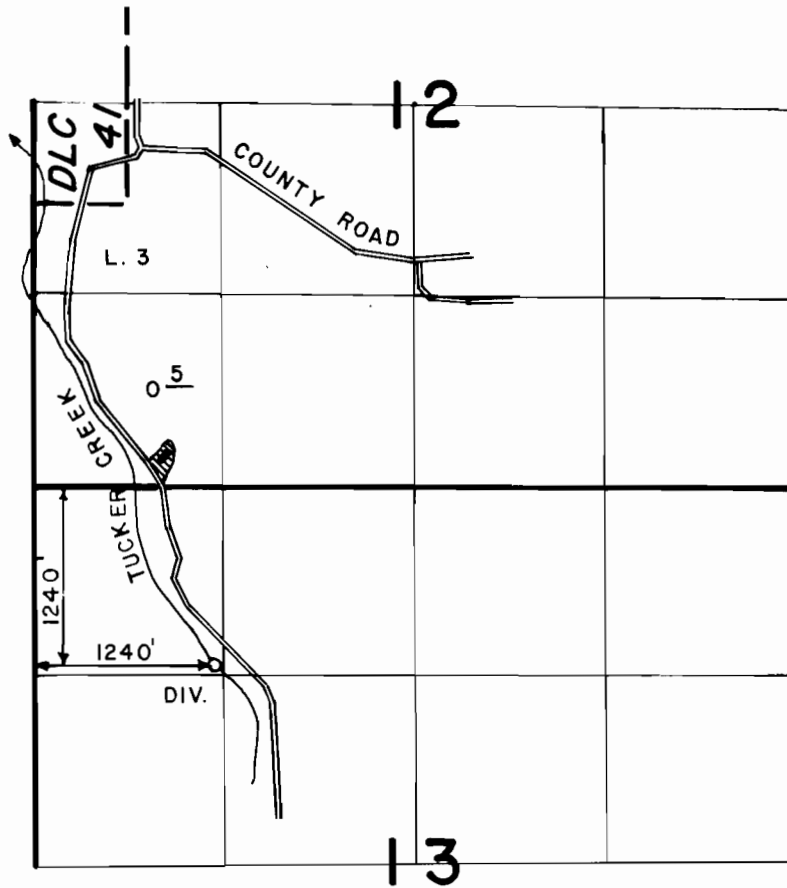

SCALE: 4" = 1 MILE

FINAL PROOF SURVEY
UNDER

Application No. 60629.. Permit No. 4539!.....
IN NAME OF

CLARAN H. JESSE AND MARJORIE D. JESSE

Surveyed JAN. 8..... 1988., by J. M. SCHMORDE