


T. 19S., R. 42E., W.M.

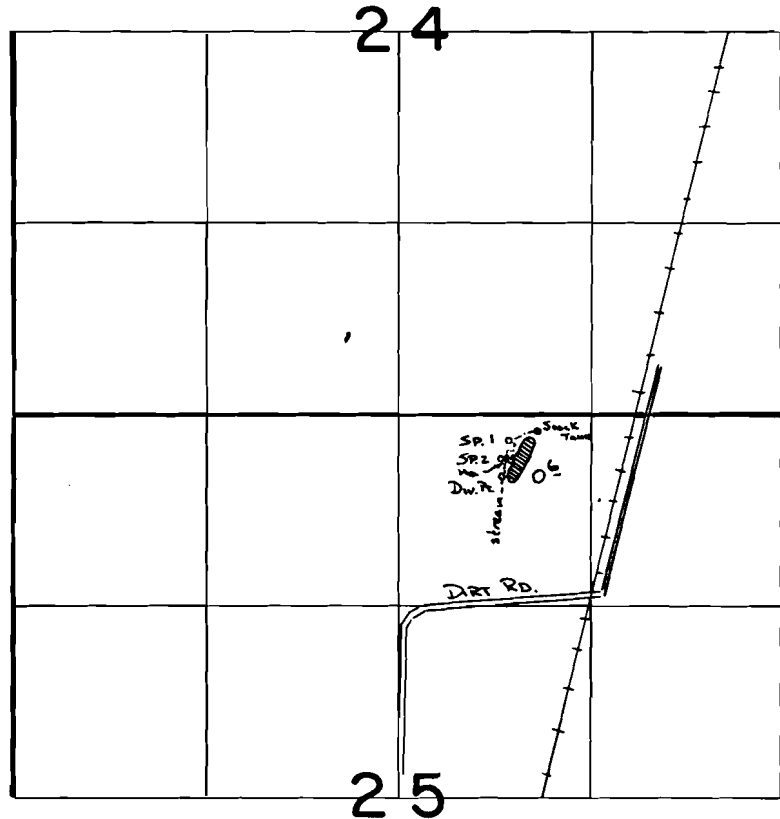

SPRING 1 Loc: 170'S. + 750'E.
 SPRING 2 Loc: 300'S. + 700'E } From N¹/₄ COR. SEC. 25
 Div. Pt. Loc: 410'S. + 700'E

Scale 1" = 1320'

FINAL PROOF SURVEY
UNDER

Application No. **60712**... Permit No. **46395**...
IN NAME OF

CECIL T. & MARGARET TUTTLE

Surveyed 5-26..... 1988, by V.L. Church.....