


COPY

T. 37 S., R. 4 W., W. M.

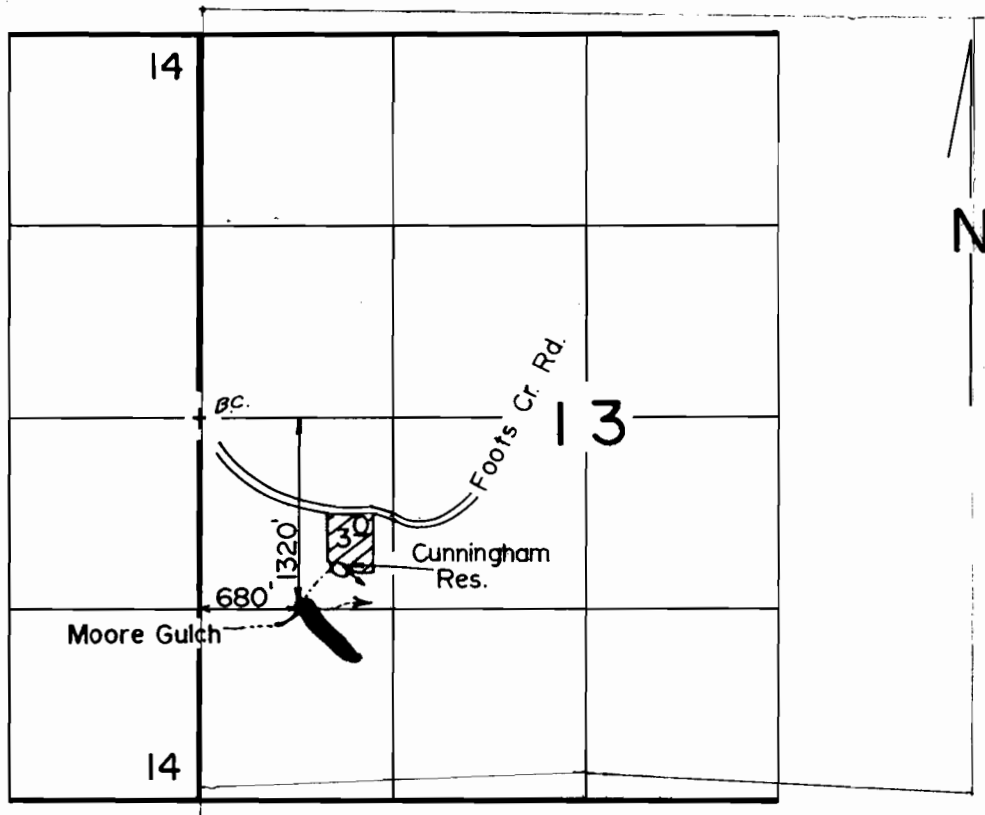

Scale: 1" = 1320'

FINAL PROOF SURVEY

UNDER

R-60908

R-8277

Application No. 60909 Permit No. 45843...

IN NAME OF

DAVID ELLIOTT CUNNINGHAM

Surveyed AUG. 30. 1988, by B. S. JAMES