


# T. 37 S., R. 4 W., W. M.

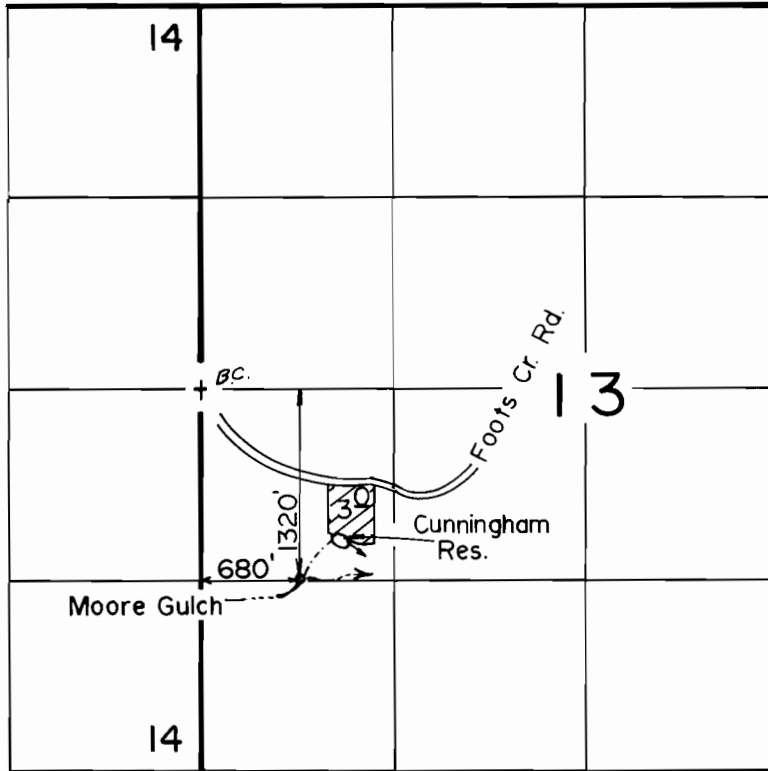

Scale: 1" = 1320'

## FINAL PROOF SURVEY

UNDER

R-60908      R-8277

Application No. ~~60909~~ Permit No. ~~45843~~...

IN NAME OF

DAVID.....ELLIOTT.....CUNNINGHAM

Surveyed AUG. 30. 1988, by B. S. JAMES...