


T. 3 S., R. 3 W., W.M.

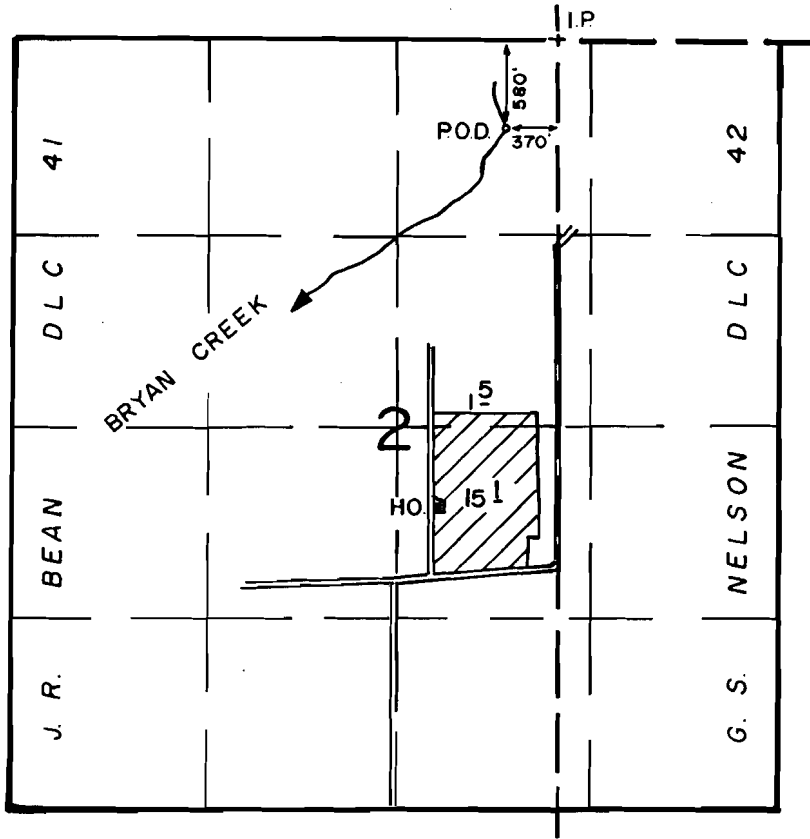

1" = 1320'

FINAL PROOF SURVEY
UNDER

Application No. 60954 Permit No. 45358

IN NAME OF

PAUL HART

Surveyed JULY 20 1990, by T.M. WARREN