


T. 37 S., R. 5 W., W. M.

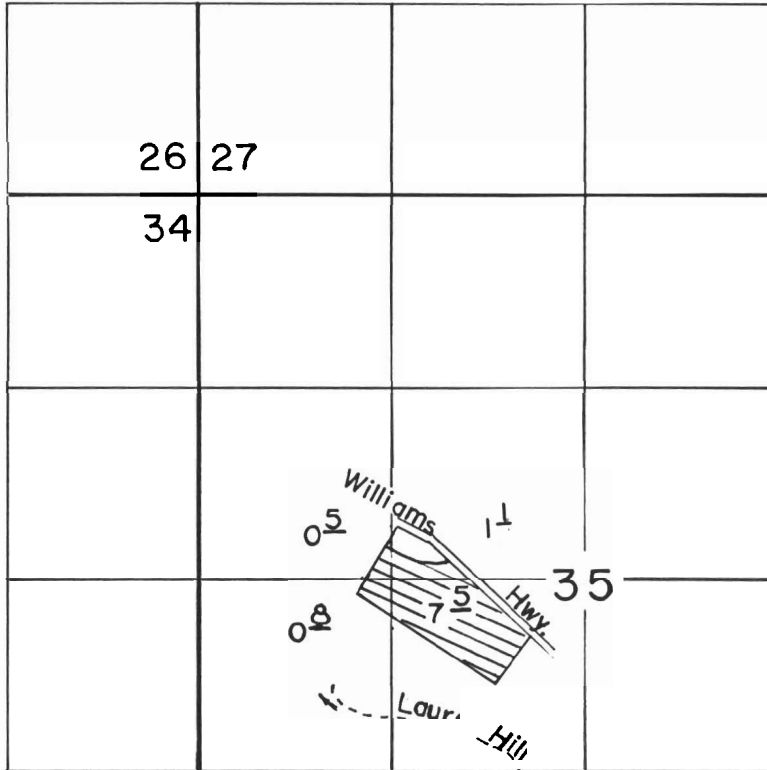

Scale: 1" = 1320'

Laurel Hill Div. Pt. :

SW 1/4 NE 1/4 Sec. 1, T.38S, R.5W,WM.
125' N. & 500' E. from C/cor. Sec. 1

FINAL PROOF SURVEY UNDER

Application No. 61094 Permit No. 48449
IN NAME OF

..... LYLE WOODCOCK

Surveyed AUG. 23, 1988, by B.S. JAMES.....