


T.4 S., R.12 E., W. M.

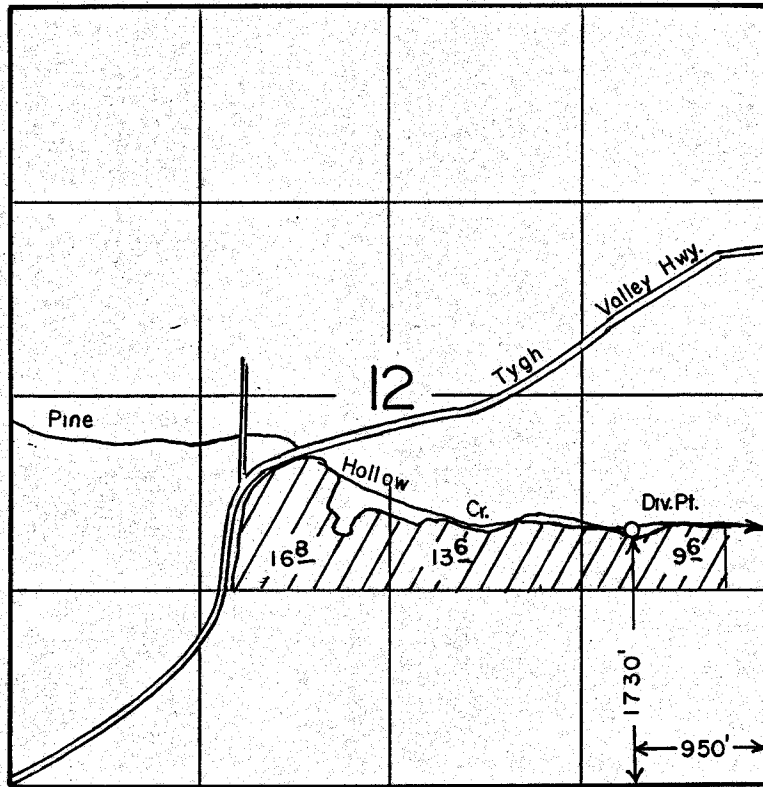

SCALE: 1" = 1320'

FINAL PROOF SURVEY
UNDER

Application No. 61348... Permit No. 46454.....
IN NAME OF

.....WILLIAM.....R.....McALLISTER.....

Surveyed APRIL 15 1989, by V. L. CHURCH.....