


RECEIVED
SEP 11 1981
WATER RESOURCES DEPT
SALEM, OREGON

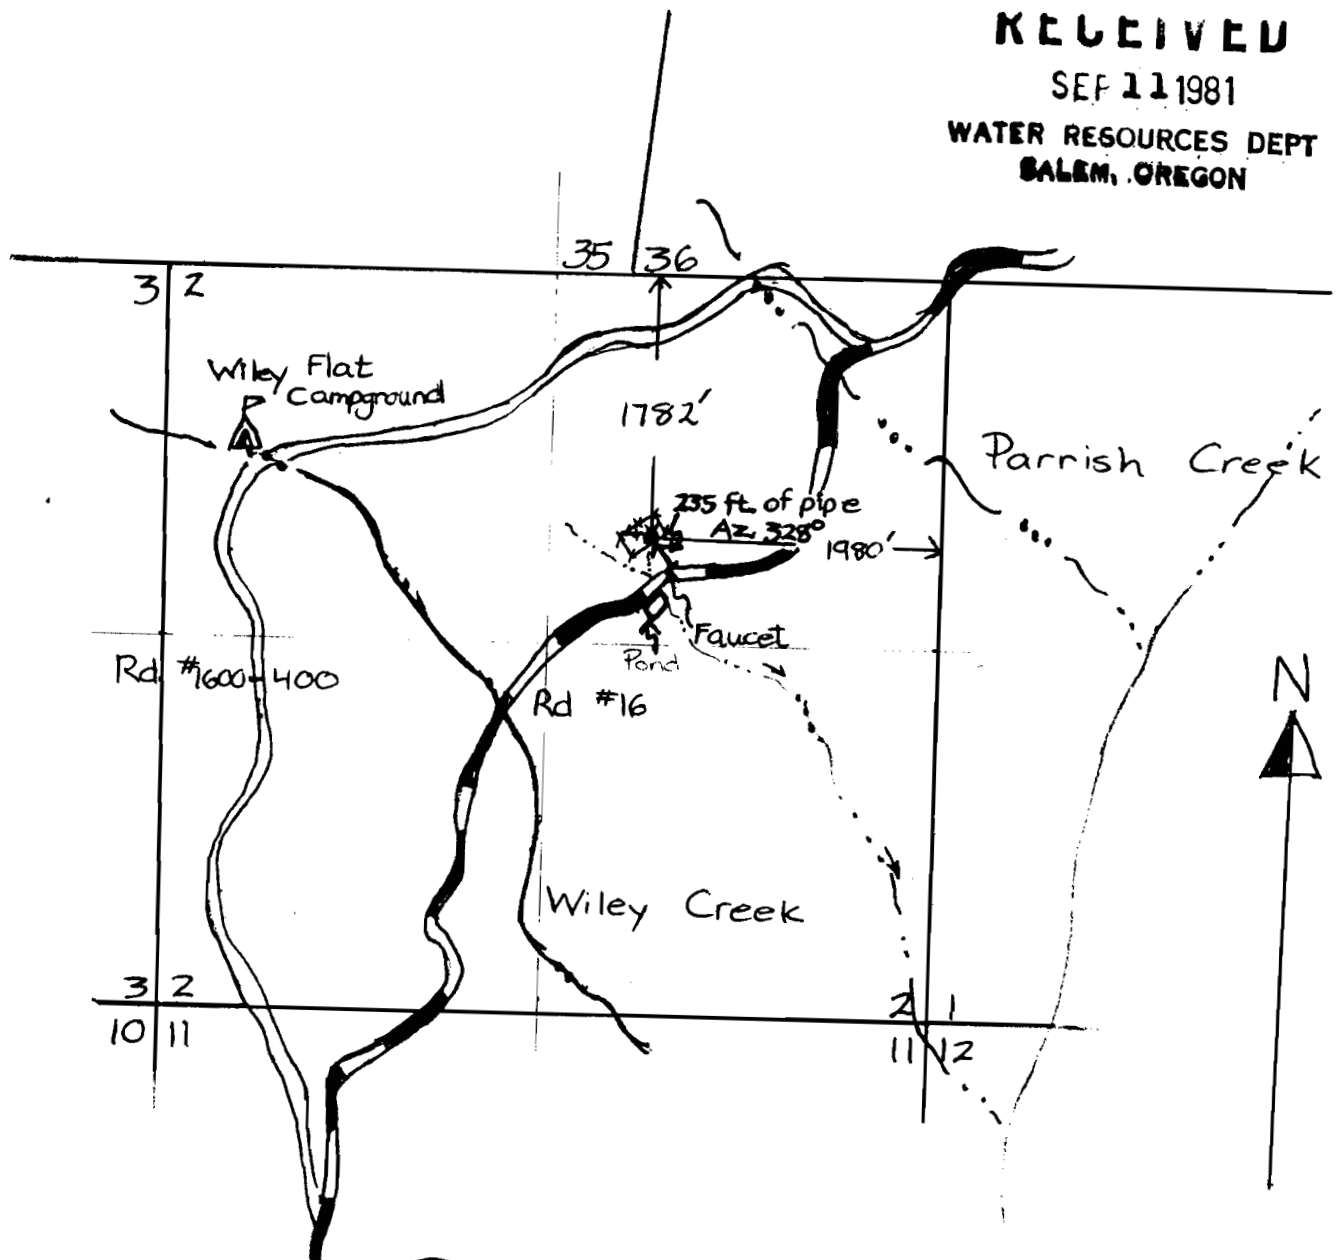

Parrish Spring

SW $\frac{1}{4}$, NE $\frac{1}{4}$, Sec. 2, T18S, R20E, W.M.

Scale : 4" = 1 mile

Application No. 62719
Permit No. 48652

65466