


RECEIVED

SEP 11 1981

WATER RESOURCES DEPT  
SALEM, OREGON

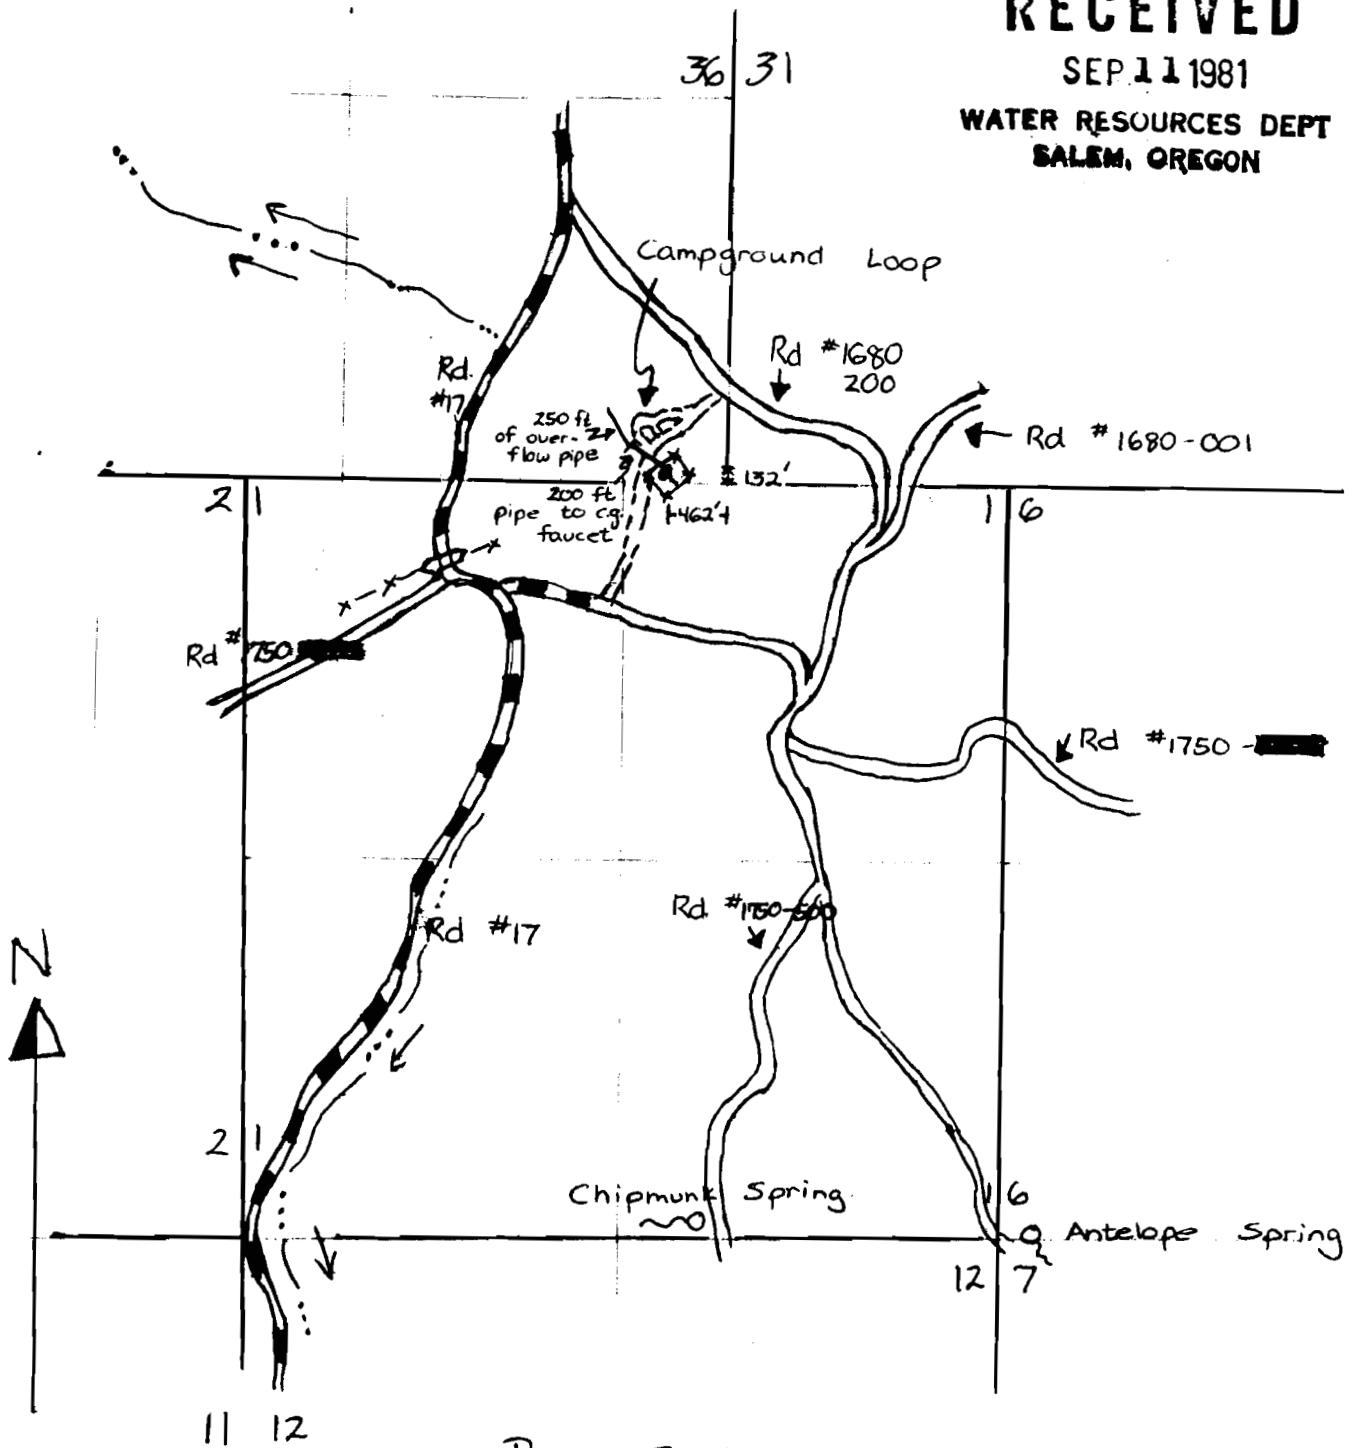

Pine Spring  
Pine Creek Campground

SE  $\frac{1}{4}$ , SE  $\frac{1}{4}$ , Sec. 36, T17S, R19E, W.M.

Scale : 4" = 1 mile

Application No. 62721

Permit No. 48654

C-65467

48654