


T. 17S., R. 20E.,
Section 22

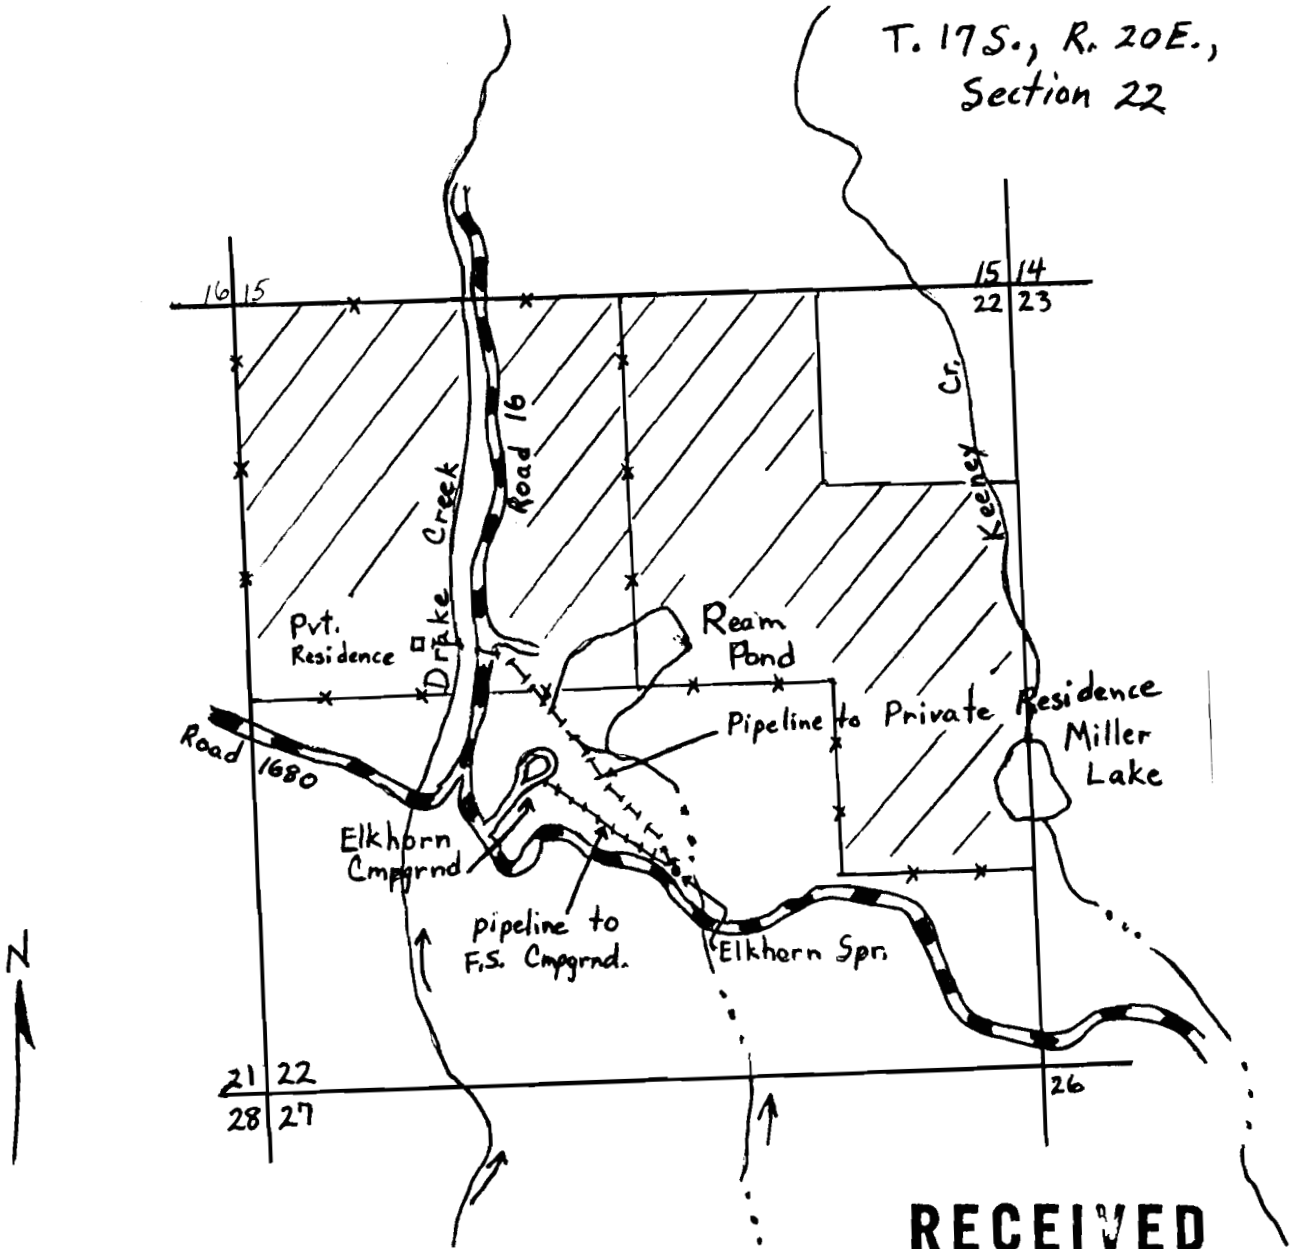

SCALE 4 INCHES = 1 MILE

RECEIVED

SEP 11 1981

WATER RESOURCES DEPT
SALEM, OREGON

Application No. 62744
Permit No. 48677

65468

48677